
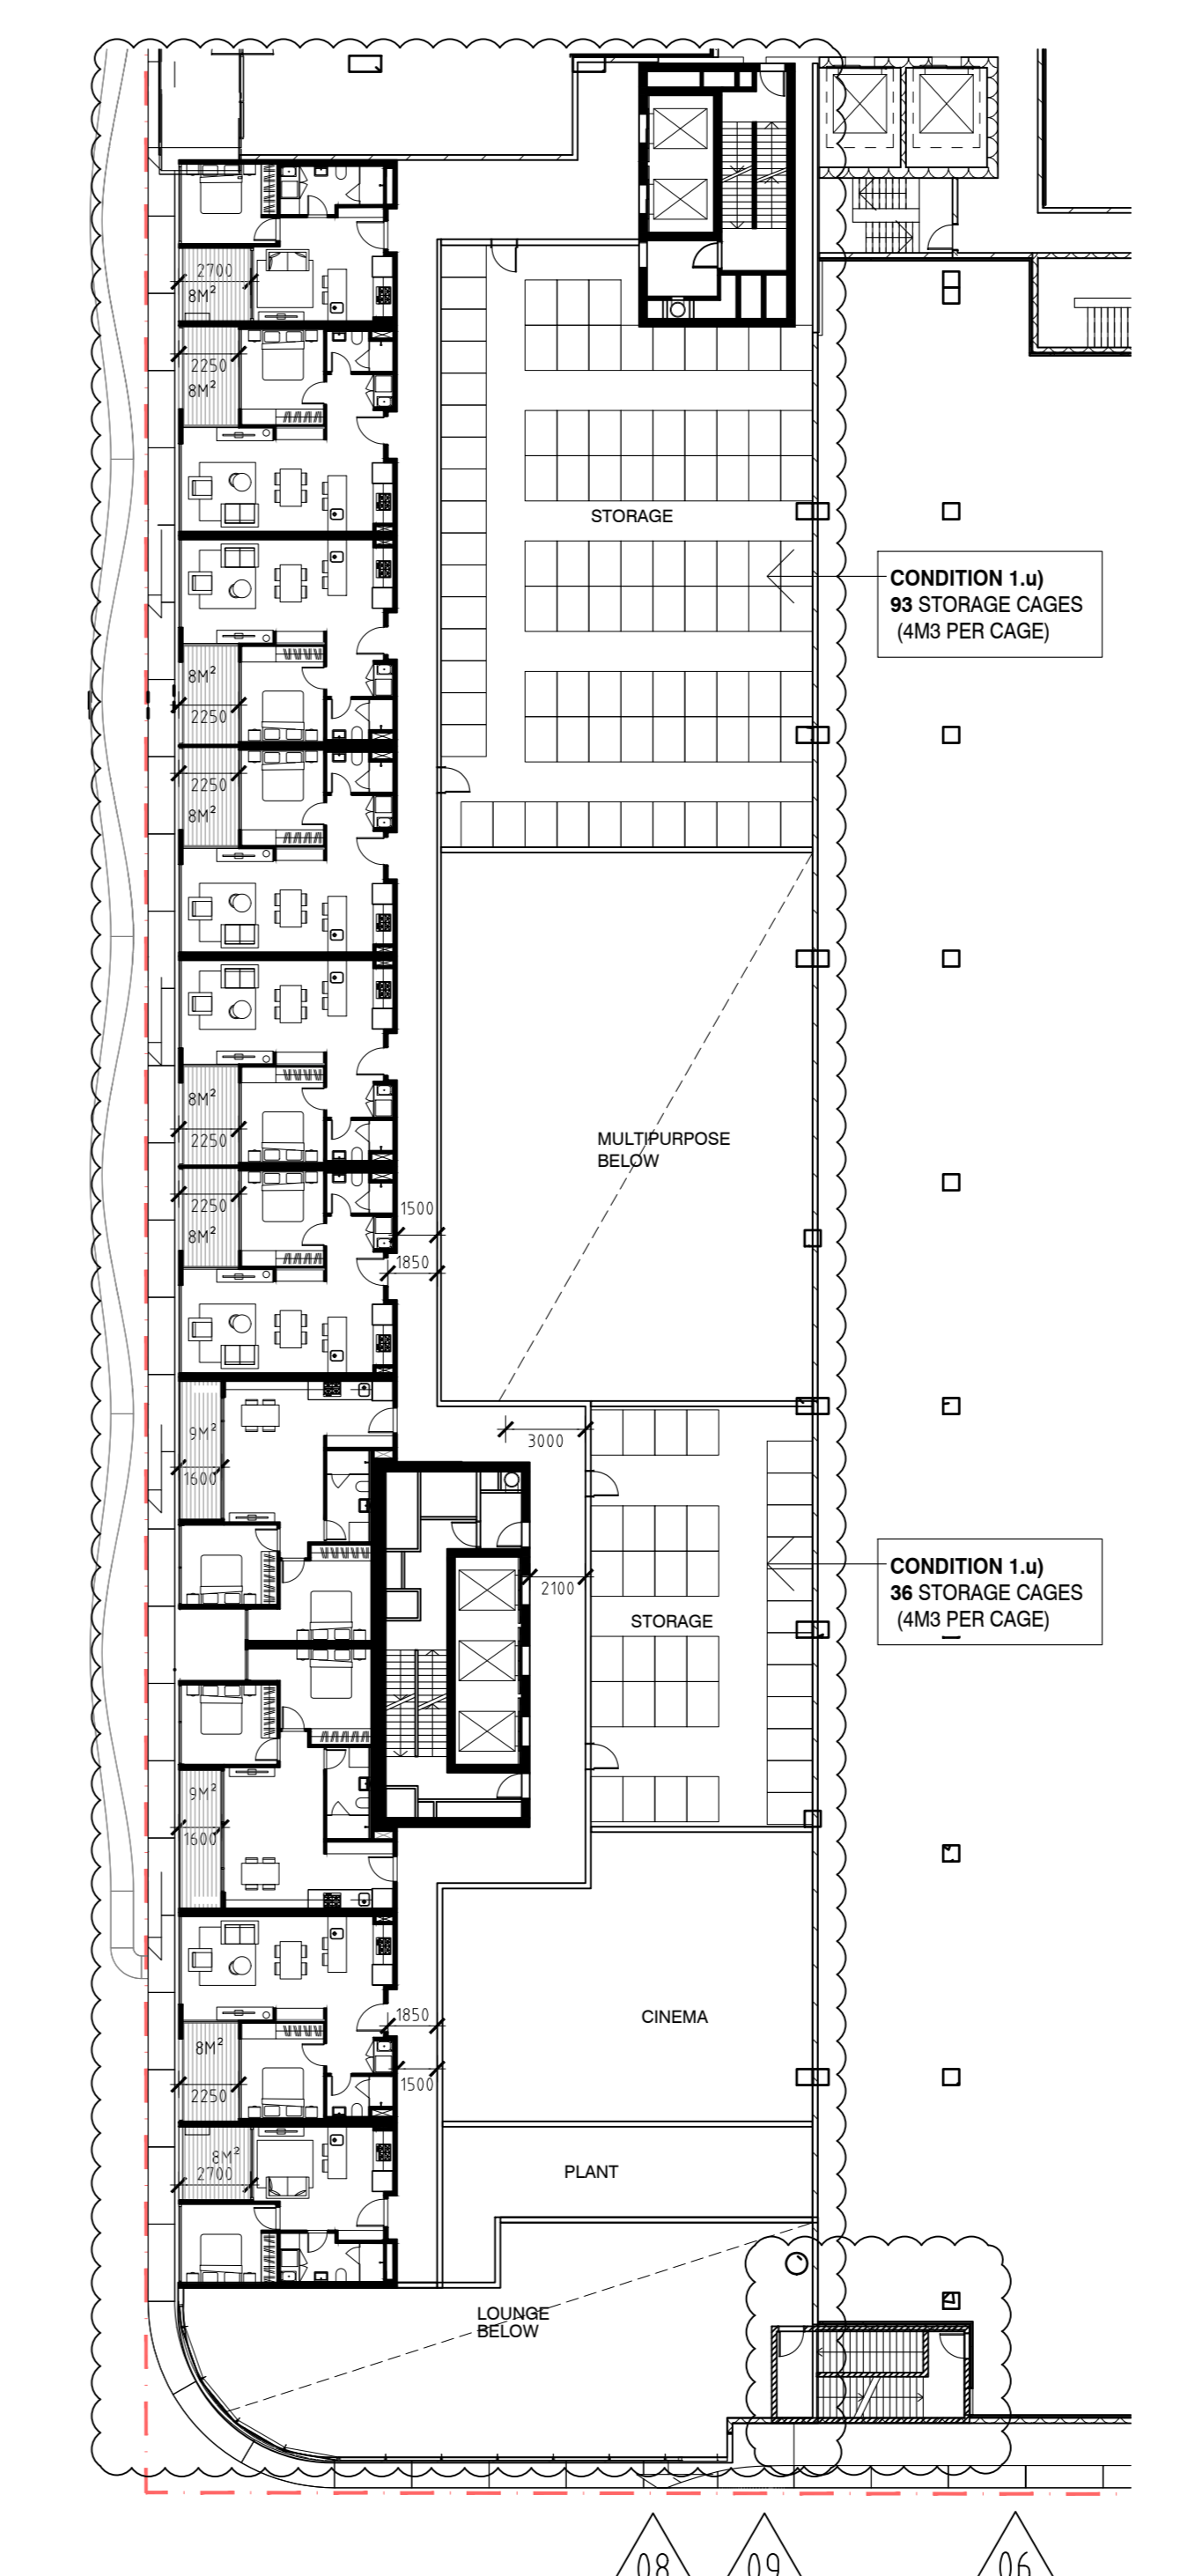
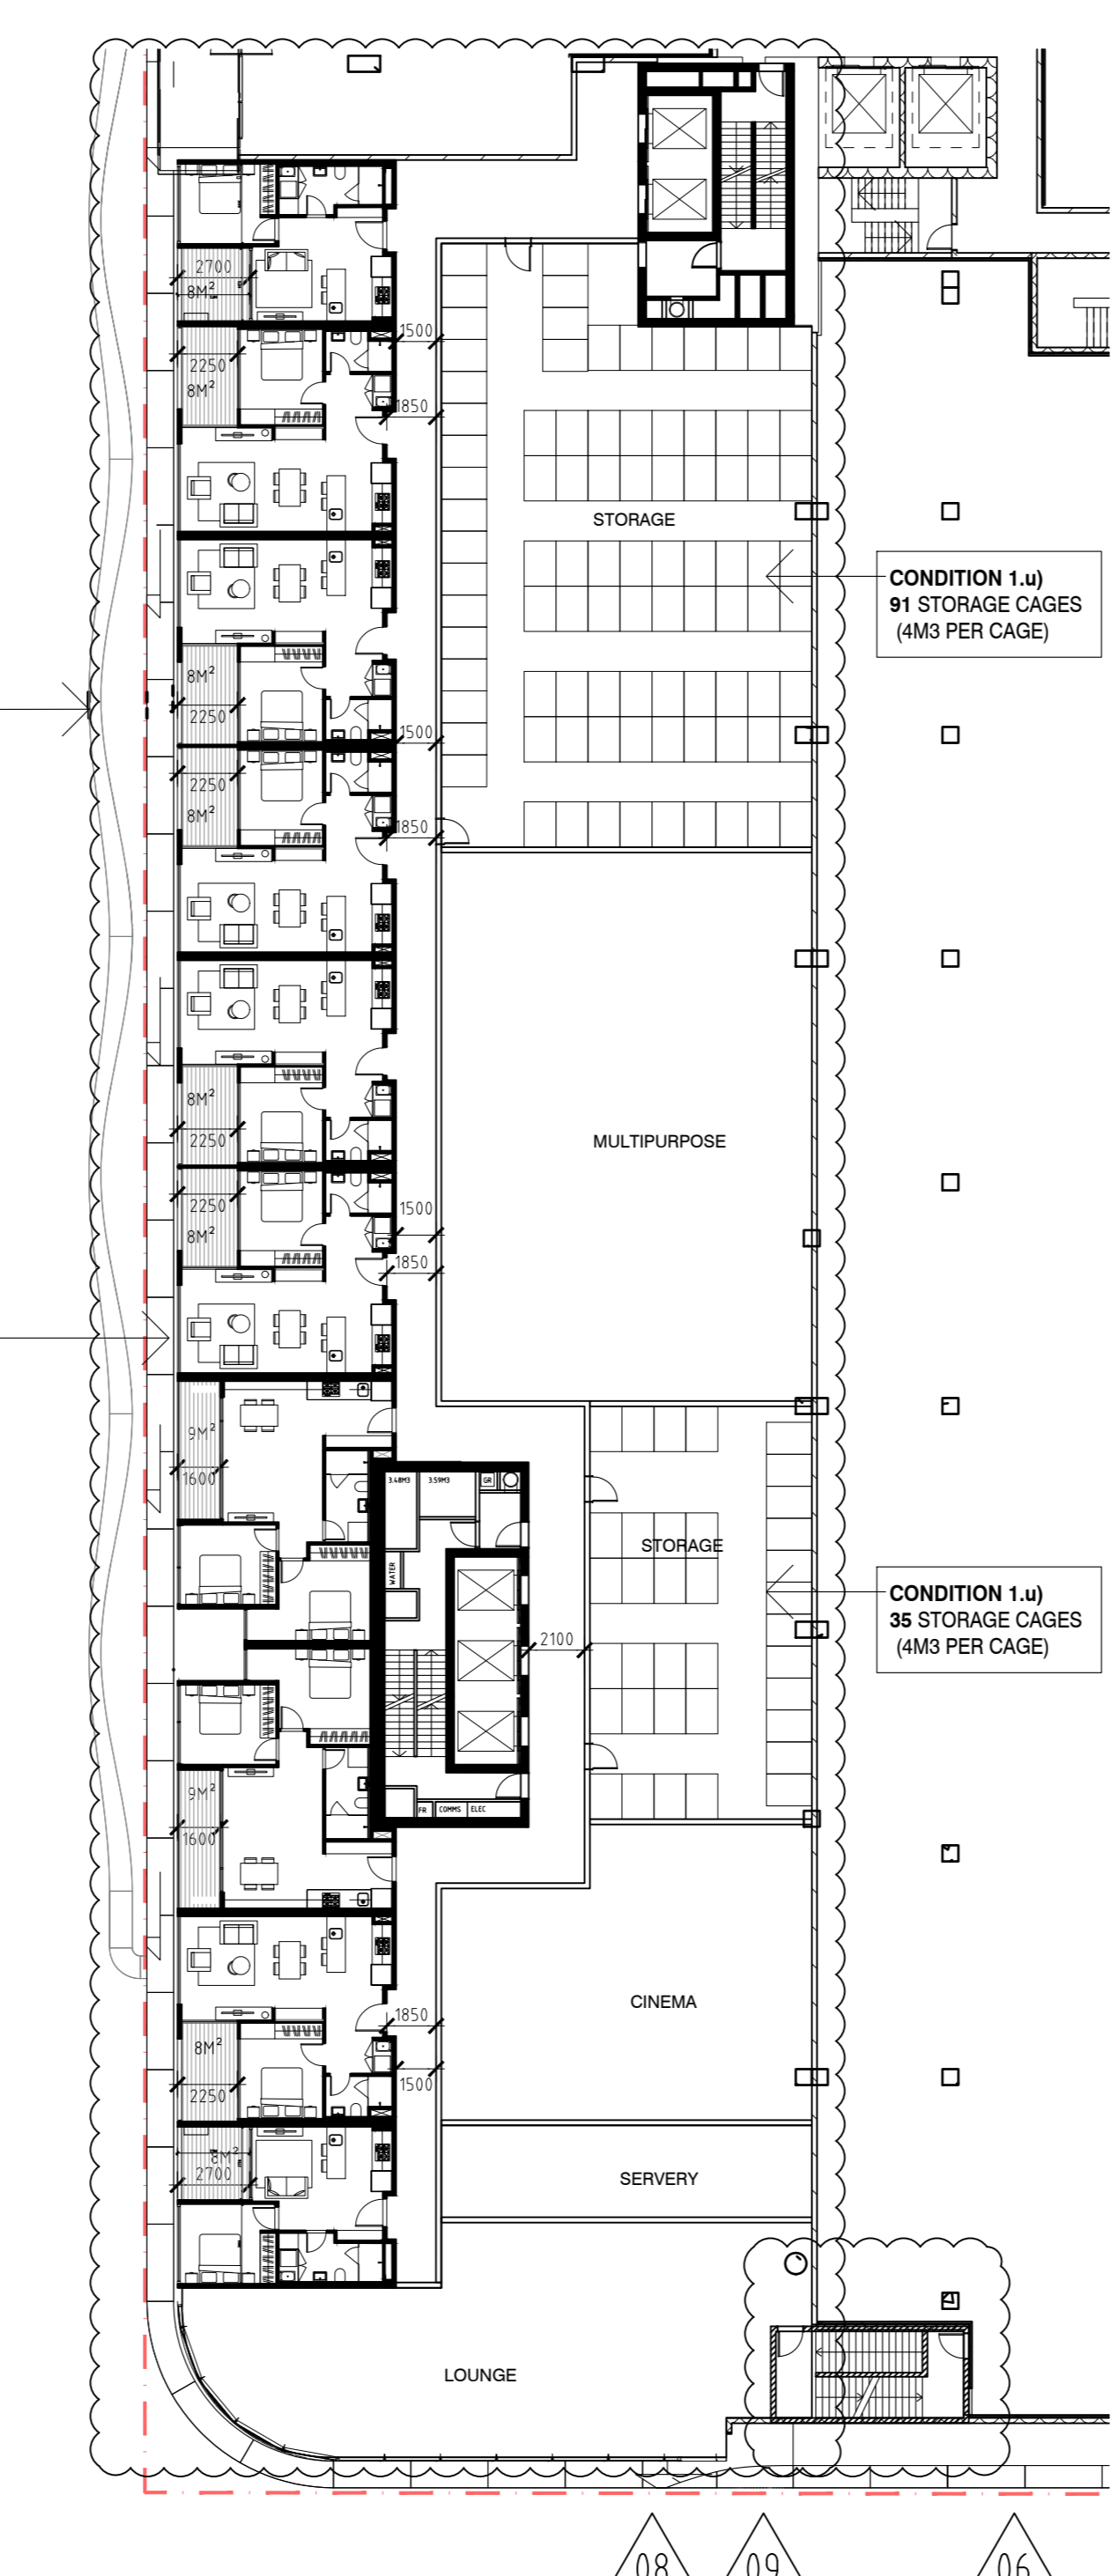
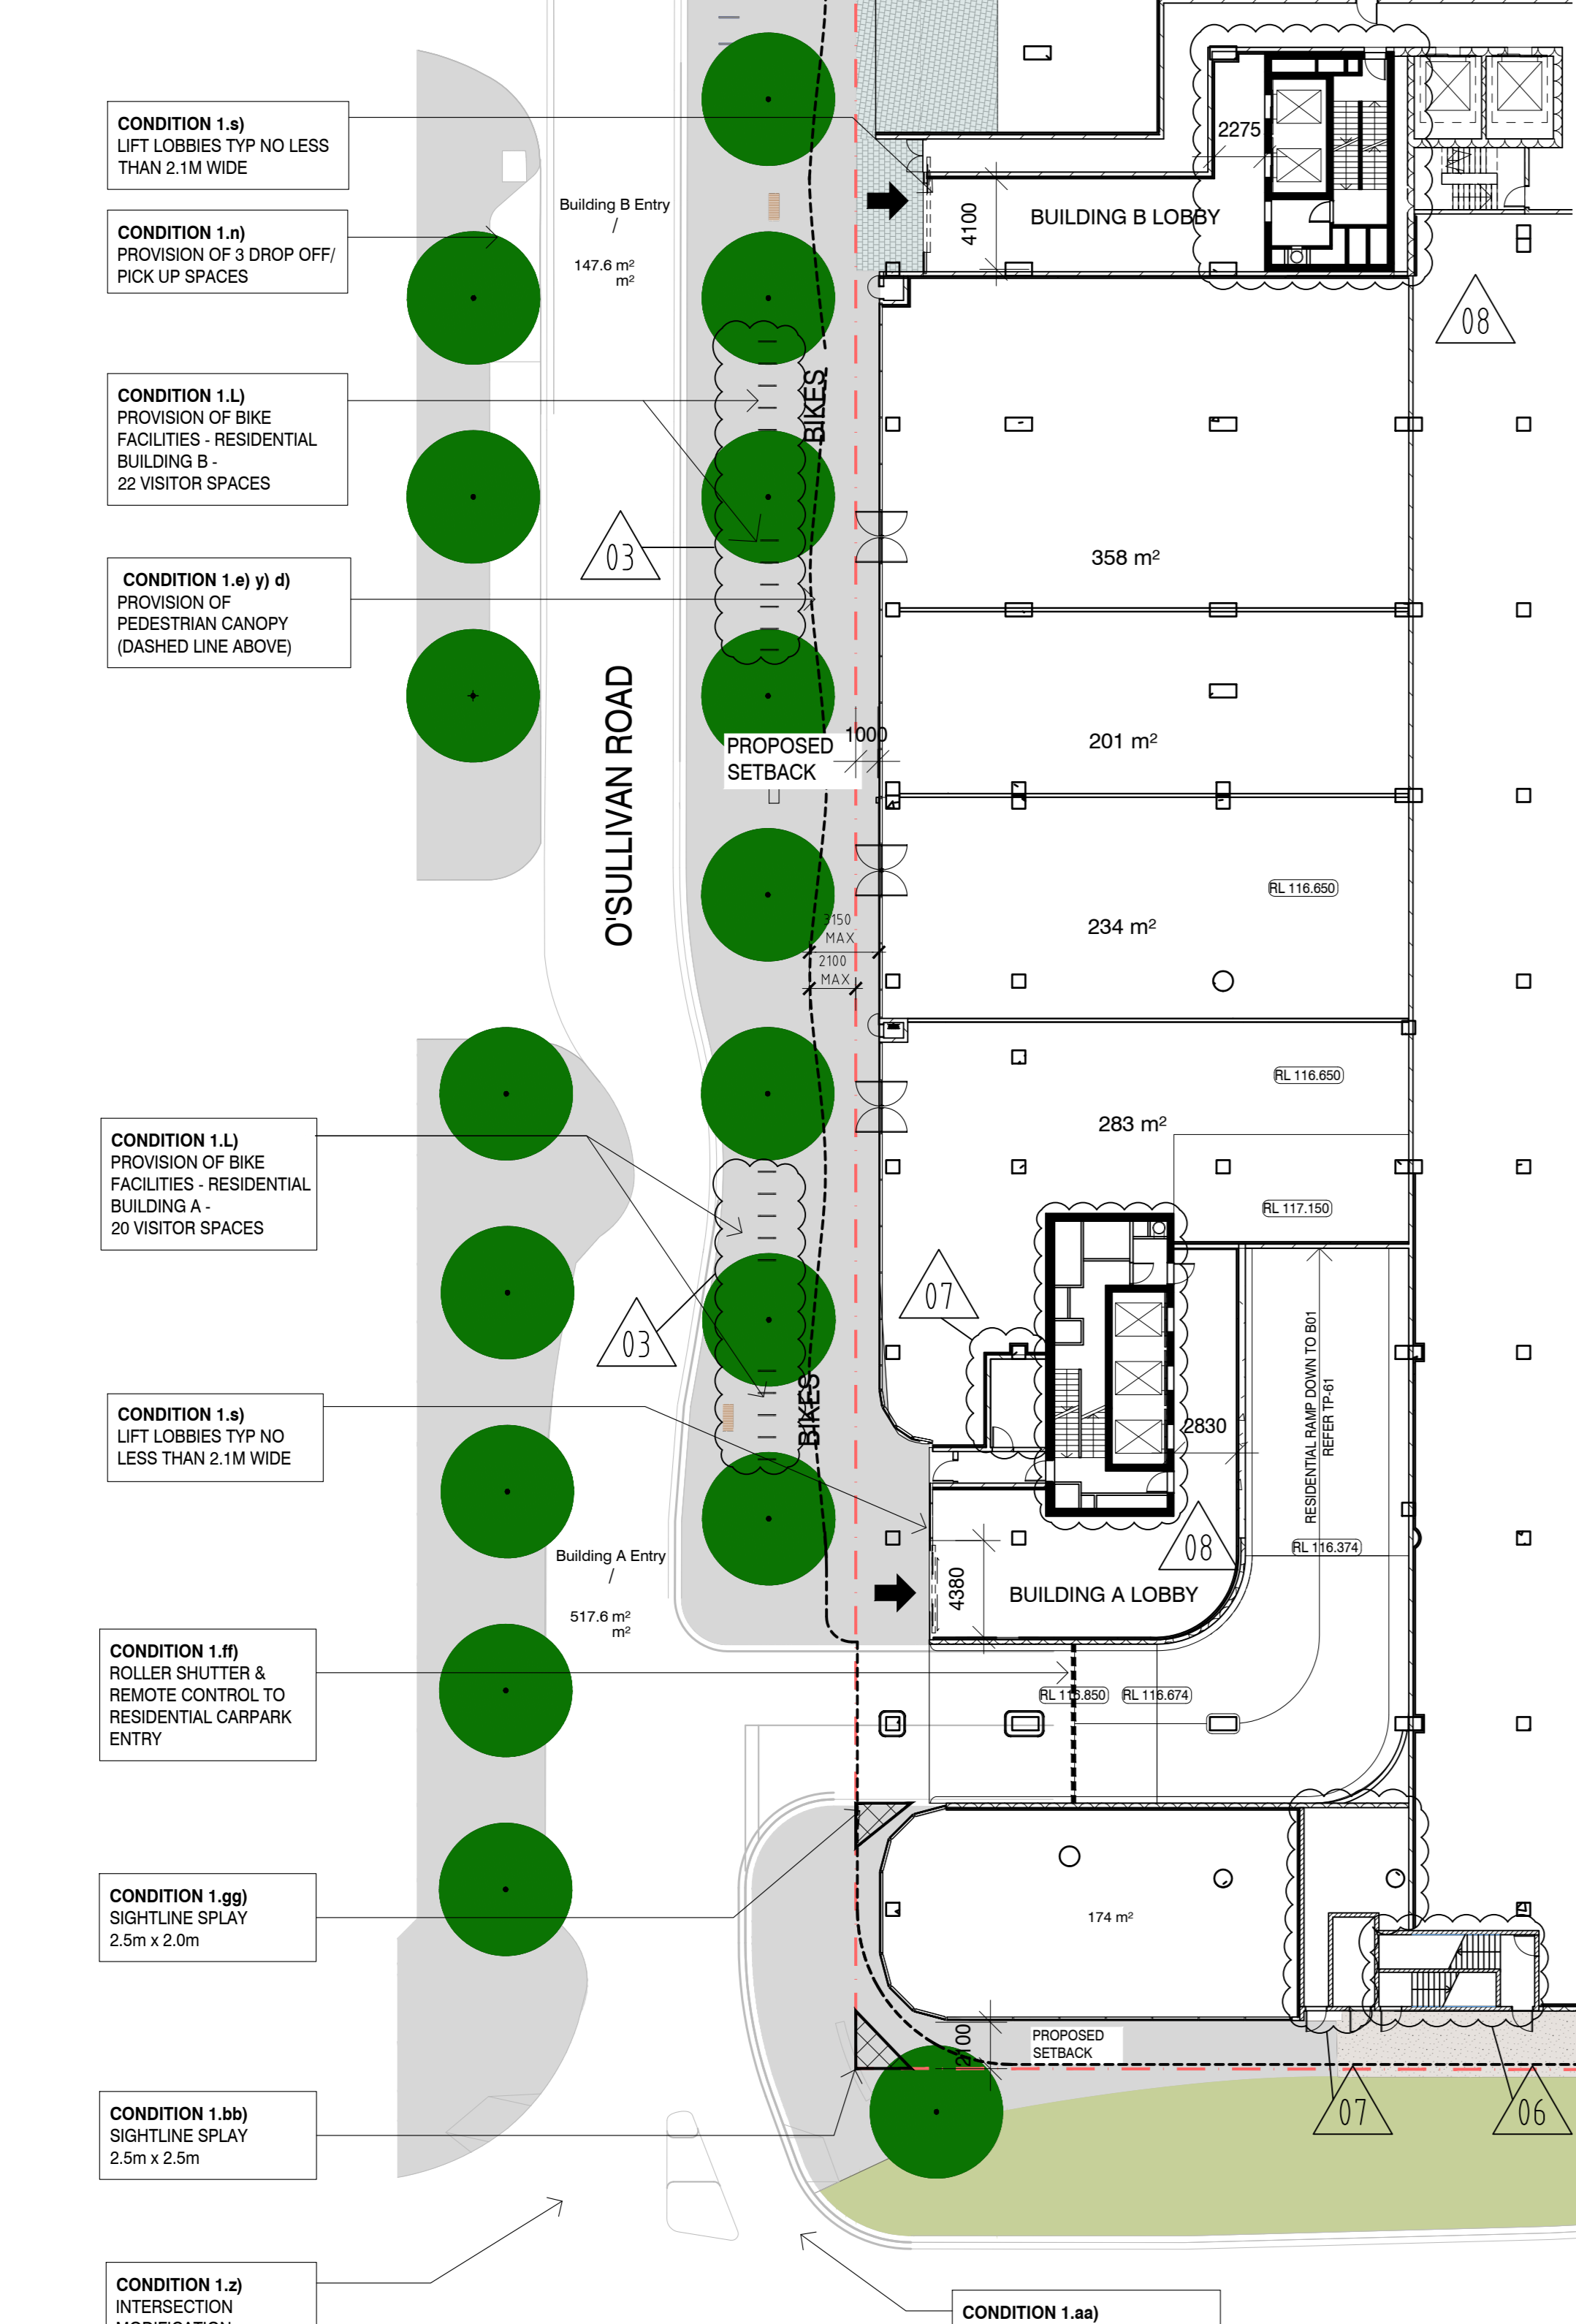
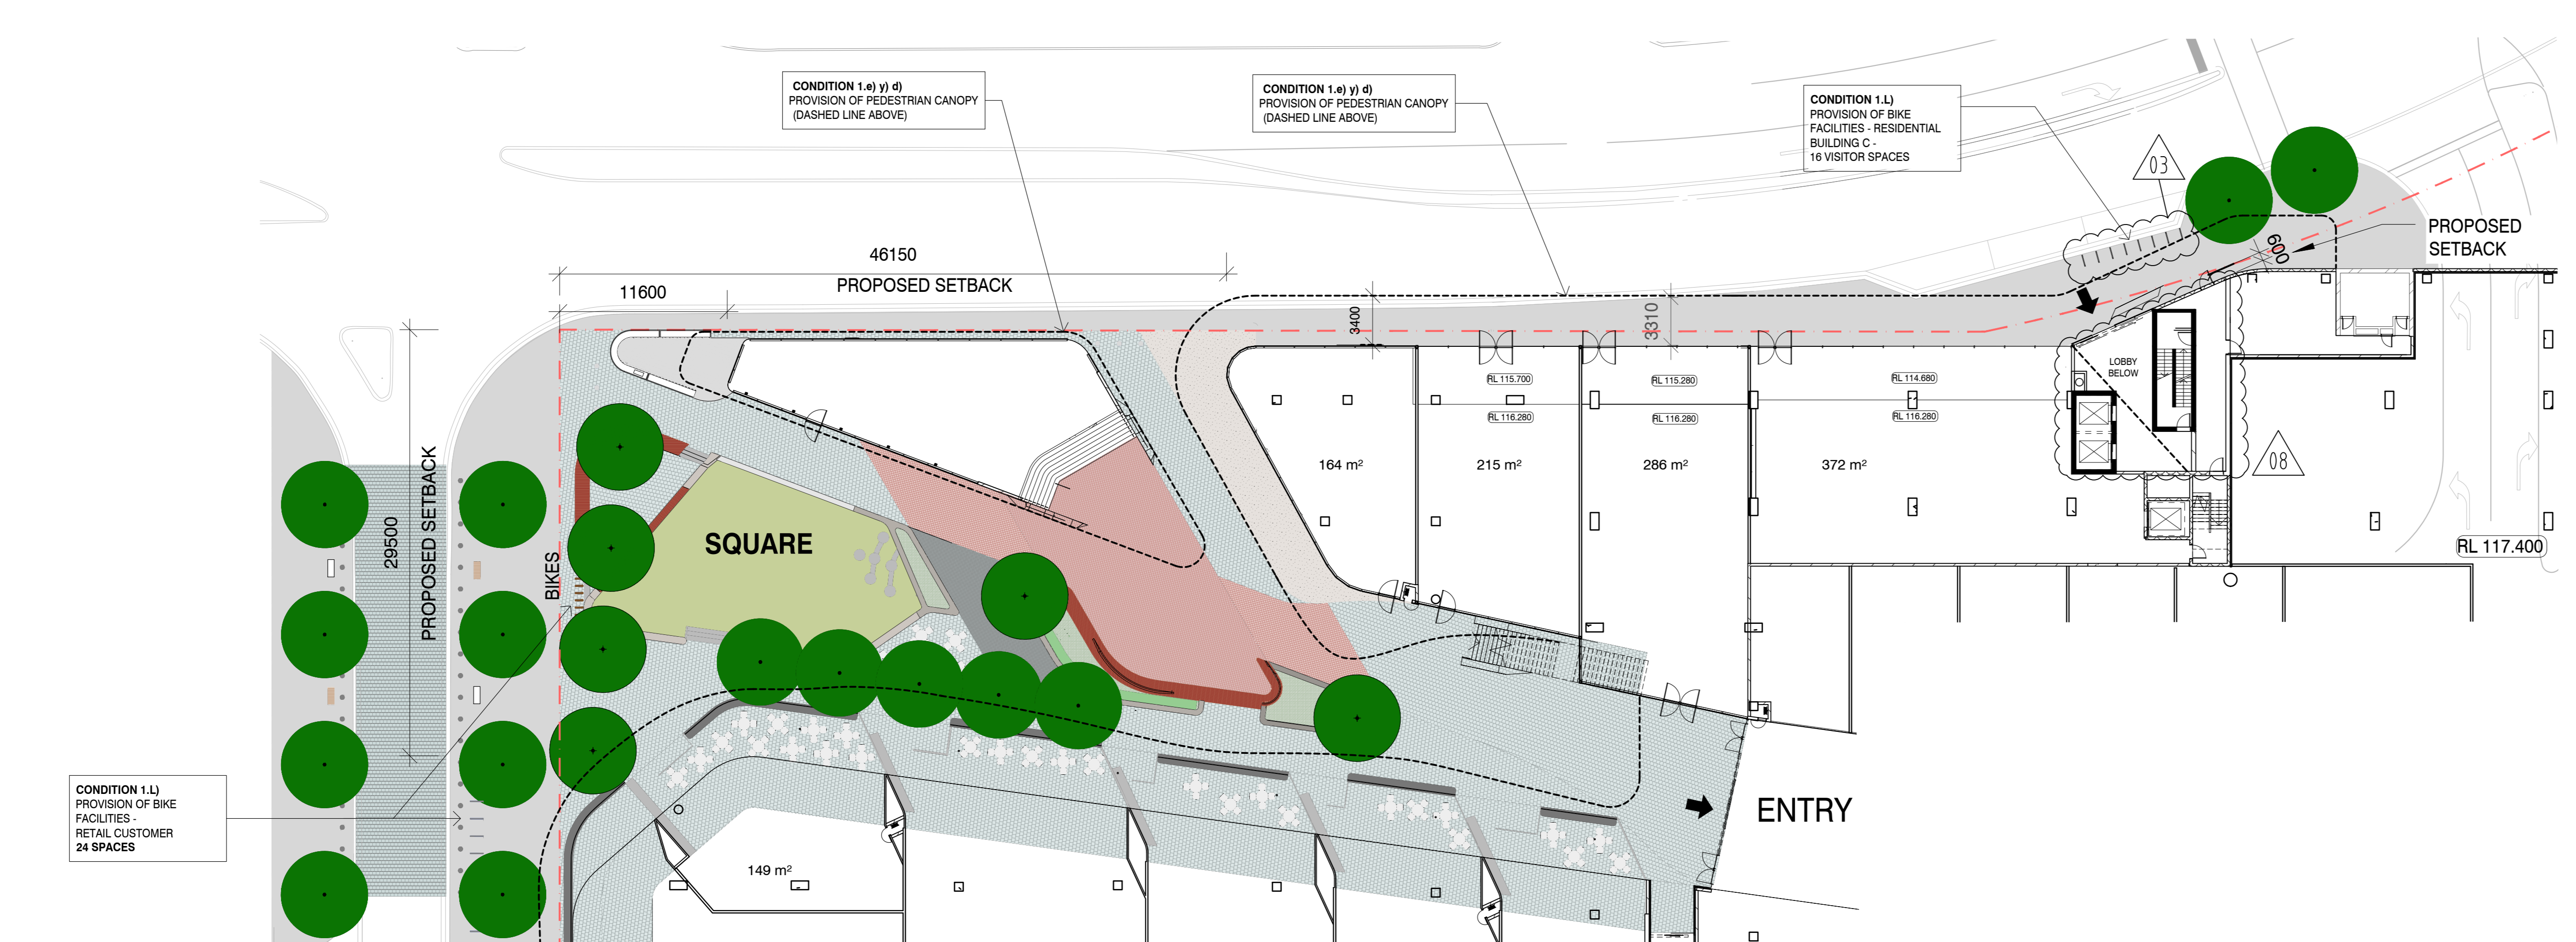


Rev	Date	Description
A	21/01/25	DP PD ISSUED FOR TOWN PLANNING
B	25/06/25	15 JN ISSUED FOR TOWN PLANNING (REVISED)
C	28/01/26	15 JN ISSUED FOR TOWN PLANNING AMENDMENT




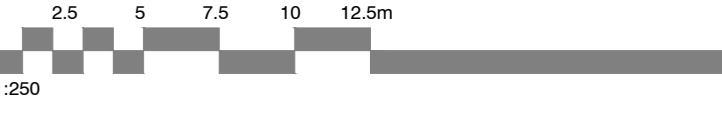

NOTE: EXISTING TREES NOT SHOWN FOR CLARITY

LEGEND	
TOWN PLANNING APPLICATION MARCH 2015	TOWN PLANNING ENDORSEMENT JUNE 2015
BASEMENT G0	BASEMENT G0
BASEMENT G1	BASEMENT G1
BASEMENT G2	BASEMENT G2
LEVEL 1	LOWER GROUND
LEVEL 1.5	LOWER GROUND MEZZANINE
LEVEL 2	GROUND LEVEL
LEVEL 3	LEVEL 1
LEVEL 4	LEVEL 2

**GENERAL NOTES**  
 ECOLOGICALLY SUSTAINABLE DEVELOPMENT (ESD):  
 THE DEVELOPMENT WILL INCORPORATE A RANGE OF ESD AND WATER SENSITIVE URBAN DESIGN (WSUD) INITIATIVES AND MEET OR EXCEED ALL RELEVANT FEDERAL AND STATE GOVERNMENT STATUTORY OBLIGATIONS WITH REGARD TO ENERGY AND WATER CONSERVATION, PASSIVE DESIGN OF BUILDINGS, WASTE MANAGEMENT, WATER SENSITIVE URBAN DESIGN AND WATER PLANNING PROCESSES. THE PROJECT WILL ALSO BE ASSESSED AGAINST THE GREEN STAR COMMITMENT AND GREEN STAR DESIGN AND IS BUILT SUSTAINABILITY TOOLS AND WILL TARGET A FOUR STAR (BEST PRACTICE) OUTCOME. GREEN STAR COMMITMENT MEETS AND EXCEEDS THE SUSTAINABILITY REQUIREMENTS AS OUTLINED IN THE MOWSHAW PLANNING SCHEME.  
 BALCONY DIVISIONS:  
 INTERFERENCE PRIVACY SCREENS MINIMUM 1100MM HEIGHT ALUMINIUM FRAMED GLAZED OPAQUE PANEL.

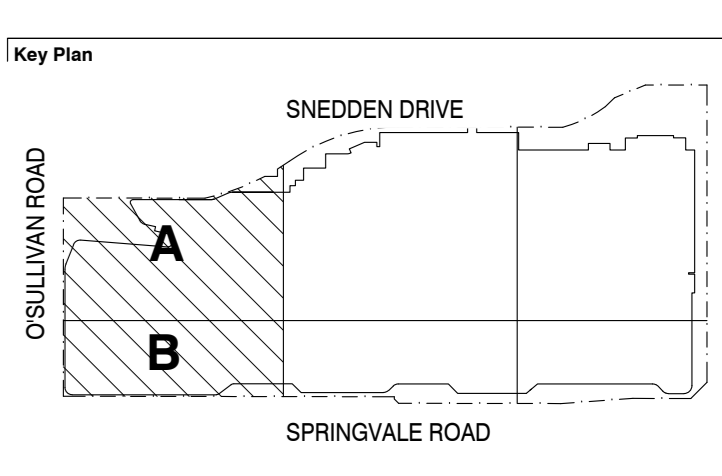

Client  
**VICINITY CENTRES**  
 Consultant  
**NHArchitecture** Level 7 Carrons House  
 12/20 Flinders Lane  
 Melbourne, Australia 3000  
 Telephone: +613 9654 4956  
 Facsimile: +613 9664 4928  
 www.nharchitecture.com.au  
**TOWN PLANNING**

1 LEVEL 01 PLAN  
 TP-31 1: 250


2 LEVEL 01 PLAN  
 TP-31 1: 250

3 LEVEL 01M PLAN  
 TP-31 1: 250

Project Name  
**THE GLEN SHOPPING CENTRE**  
 235 Springvale Road, Glen Waverley, 3150  
 Drawing Name  
**PROPOSED GROUND, LEVEL 01 & LEVEL 01 MEZZANINE**  
 Architect: PD Drawn By: TS Scale @ A0: 1: 500  
 Project Number: A120520 Drawing Number: TP-31 Revision: C

Rev	Date	Description
A	21/01/25	DP PD ISSUED FOR TOWN PLANNING
B	25/06/25	15 JV ISSUED FOR TOWN PLANNING ENDORSEMENT
C	28/01/26	15 JV ISSUED FOR TOWN PLANNING AMENDMENT



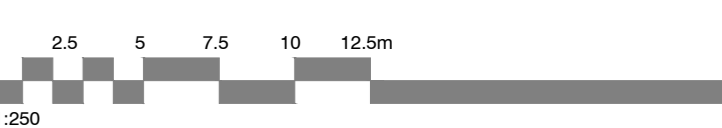

NOTE: EXISTING TREES NOT SHOWN FOR CLARITY

LEGEND	
TOWN PLANNING APPLICATION MARCH 2016	TOWN PLANNING ENDORSEMENT JUNE 2016
BASEMENT 02	BASEMENT 02
BASEMENT 02	BASEMENT 02
BASEMENT 02	BASEMENT 02
LEVEL 1	LOWER GROUND
LEVEL 1.5	LOWER GROUND MEZZANINE
LEVEL 2	GROUND LEVEL
LEVEL 3	LEVEL 1
LEVEL 4	LEVEL 2


**GENERAL NOTES**

ECOLOGICALLY SUSTAINABLE DEVELOPMENT (ESD):

THE DEVELOPMENT WILL INCORPORATE A RANGE OF ESD AND WATER SENSITIVE URBAN DESIGN (WSUD) INITIATIVES AND MEET OR EXCEED ALL RELEVANT FEDERAL AND STATE GOVERNMENT STATUTORY OBLIGATIONS WITH REGARD TO ENERGY AND WATER CONSERVATION, PASSIVE DESIGN OF BUILDINGS, WASTE MANAGEMENT, WATER SENSITIVE URBAN DESIGN AND WATER PLANNING PROCESSES. THE PROJECT WILL ALSO BE ASSESSED AGAINST THE GREEN STAR COMMUNITIES AND GREEN STAR DESIGN AND AS BUILT SUSTAINABILITY TOOLS AND WILL TARGET A FOUR STAR (BEST PRACTICE) OUTCOME. GREEN STAR COMMUNITIES MEETS AND EXCEEDS THE SUSTAINABILITY REQUIREMENTS AS OUTLINED IN THE MOWSHAW PLANNING SCHEME.

BALCONY DIVISIONS:

INTERFERENCE PRIVACY SCREENS MINIMUM 1700MM HEIGHT ALUMINIUM FRAMED GLAZED OPAQUE PANEL.

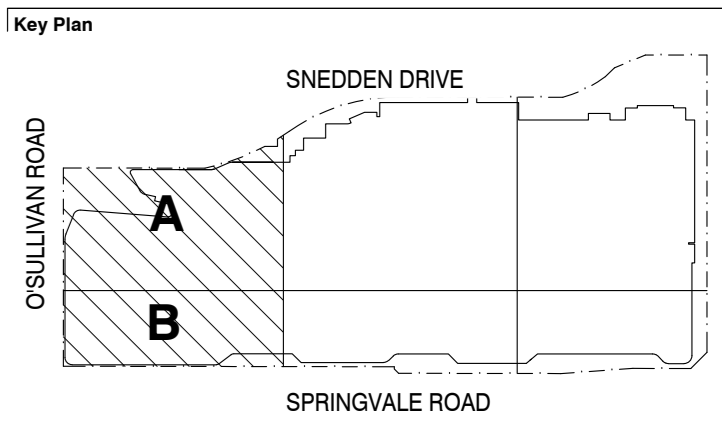

Client

Consultant

**NHArchitecture** Level 7 Carrons House  
12/20 Flinders Lane  
Melbourne, Australia 3000  
Telephone: +613 9654 4956  
Facsimile: +613 9654 4928  
www.nharchitecture.com.au

**TOWN PLANNING**


Project Name  
**THE GLEN SHOPPING CENTRE**  
235 Springvale Road, Glen Waverley, 3150

Drawing Name  
**PROPOSED LEVEL 02**

Architect	Drawn By	Scale @ A0
PD	TS	1 : 250
Project Number	Drawing Number	Revision
A120520	TP-32	C

Rev	Date	Description
A	21/01/25	DP PD ISSUED FOR TOWN PLANNING
B	31/03/25	DP PD ISSUED FOR TOWN PLANNING - RESPONSE TO COUNCIL BY PROPOSED SPECIAL APPOINTMENT THROUGH FLOORING
C	24/06/25	TS JV ISSUED FOR TOWN PLANNING ENDORSEMENT
D	28/11/25	TS JV ISSUED FOR TOWN PLANNING AMENDMENT



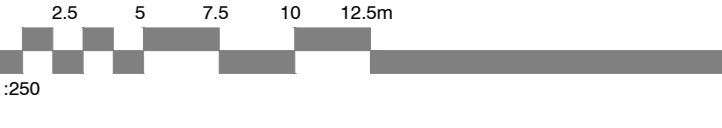


NOTE: EXISTING TREES NOT SHOWN FOR CLARITY

LEGEND	
TOWN PLANNING APPLICATION MARCH 2016	TOWN PLANNING ENDORSEMENT JUNE 2016
BASEMENT G2	BASEMENT G2
BASEMENT G1	BASEMENT G1
BASEMENT G0	BASEMENT G0
LEVEL 1	LOWER GROUND
LEVEL 1.5	LOWER GROUND MEZZANINE
LEVEL 2	GROUND LEVEL
LEVEL 3	LEVEL 1
LEVEL 4	LEVEL 2

**GENERAL NOTES**

ECOLOGICALLY SUSTAINABLE DEVELOPMENT (ESD):  
 THE DEVELOPMENT WILL INCORPORATE A RANGE OF ESD AND WATER SENSITIVE URBAN DESIGN (WSUD) INITIATIVES AND MEET OR EXCEED ALL RELEVANT FEDERAL AND STATE GOVERNMENT STATUTORY OBLIGATIONS WITH REGARD TO ENERGY AND WATER CONSERVATION, PASSIVE DESIGN OF BUILDINGS, WASTE MANAGEMENT, WATER SENSITIVE URBAN DESIGN AND WATER PLANNING PROCESSES. THE PROJECT WILL ALSO BE ASSESSED AGAINST THE GREEN STAR COMMUNITIES AND GREEN STAR DESIGN AND AS BUILT SUSTAINABILITY TOOLS AND WILL TARGET A FOUR STAR (BEST PRACTICE) OUTCOME. GREEN STAR COMMUNITIES MEETS AND EXCEEDS THE SUSTAINABILITY REQUIREMENTS AS OUTLINED IN THE MOWSHAW PLANNING SCHEME.

BALCONY DIVISIONS:  
 INTERFERENCE PRIVACY SCREENS MINIMUM 1700MM HEIGHT ALUMINIUM FRAMED GLAZED OPAQUE PANEL.

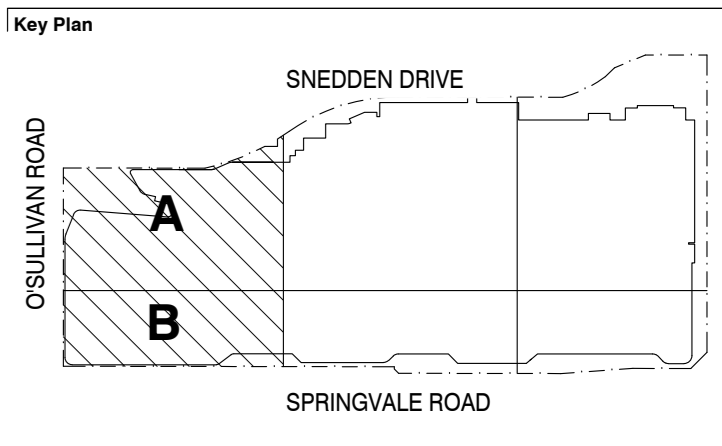

**NHArchitecture** Level 7 Carrons House  
 12-20 Flinders Lane  
 Melbourne, Australia 3000  
 Telephone +613 9654 4056  
 Facsimile +613 9654 4028  
 www.nharchitecture.com.au

**TOWN PLANNING**


Project Name  
**THE GLEN SHOPPING CENTRE**  
 235 Springvale Road, Glen Waverley, 3150

Drawing Name		
<b>PROPOSED LEVEL 03</b>		
Architect	Drawn By	Scale @ A0
PD	TS	1 : 250
Project Number	Drawing Number	Revision
A120520	TP-33	D

TP-33 LEVEL 03 PLAN  
 1 : 250

Rev	Date	Description
A	27/03/15	CM 10 ESDS FOR TOWN PLANNING
B	24/06/15	TS 14 PRELIMINARY LEVEL 04 PLAN
C	28/12/15	TS 14 ESDS FOR TOWN PLANNING AMENDMENT



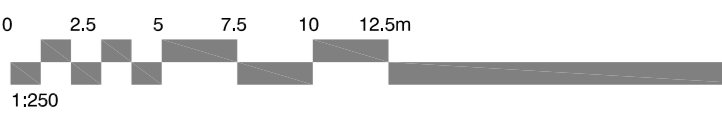

NOTE: EXISTING TREES NOT SHOWN FOR CLARITY

LEGEND	
TOWN PLANNING APPLICATION MARCH 2015	TOWN PLANNING ENDORSEMENT JUNE 2016
BASEMENT 03	BASEMENT 03
BASEMENT 02	BASEMENT 02
BASEMENT 01	BASEMENT 01
LEVEL 1	LOWER GROUND
LEVEL 1.5	LOWER GROUND MEZZANINE
LEVEL 2	GROUND LEVEL
LEVEL 3	LEVEL 1
LEVEL 4	LEVEL 2

**GENERAL NOTES**


ECOLOGICALLY SUSTAINABLE DEVELOPMENT (ESD):

THE DEVELOPMENT WILL INCORPORATE A RANGE OF ESD AND WATER SENSITIVE URBAN DESIGN (WSUD) INITIATIVES AND MEET OR EXCEED ALL RELEVANT FEDERAL AND STATE GOVERNMENT STATUTORY OBLIGATIONS WITH REGARD TO ENERGY AND WATER CONSERVATION, PASSIVE DESIGN OF BUILDINGS, WASTE MANAGEMENT, WATER SENSITIVE URBAN DESIGN AND MASTER PLANNING PROCESSES. THE PROJECT WILL ALSO BE ASSESSED AGAINST THE GREEN STAR COMMITTES AND GREEN STAR DESIGN AND AS BUILT SUSTAINABILITY TOOLS AND WILL TARGET A FOUR STAR (BEST PRACTICE) OUTCOME.

GREEN STAR COMMITTES MEETS AND EXCEEDS THE SUSTAINABILITY REQUIREMENTS AS OUTLINED IN THE MONASH PLANNING SCHEME.

BALCONY DIVISIONS:

INTERFERENCE PRIVACY SCREENS, MINIMUM 1700MM HEIGHT ALUMINIUM FRAMED GLAZED OPAQUE PANEL.

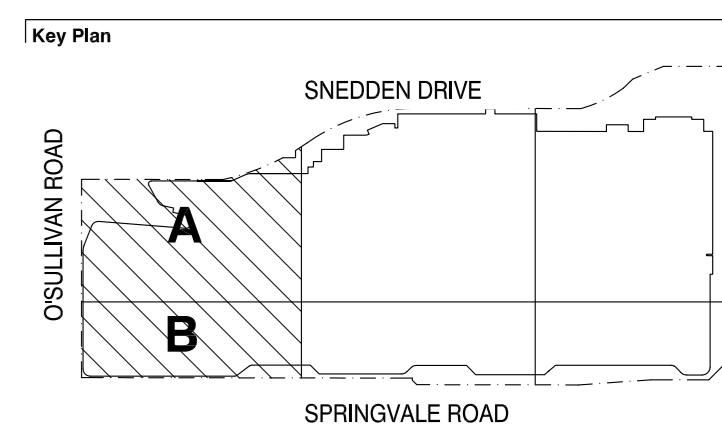

Client

Consultant

**NHArchitecture** Level 7 Galleria House  
13-20 Flinders Lane  
Melbourne, Australia 3000

TOWN PLANNING Telephone: +613 9654 4005  
Facsimile: +613 9654 4006  
www.nharchitecture.net

Project Name  
**THE GLEN SHOPPING CENTRE**  
235 Springvale Road, Glen Waverley, 3150

Drawing Name  
**PROPOSED LEVEL 04 - 07-07**

Architect Drawn by Scale @  
PD TS 1:250



Project Number Drawing Number Revision  
A120520 TP-34 C

LEVEL 04  
TP-34  
1:250

08  
10  
11

Rev	Date	Description
A	26.06.2016	TS - ISSUED FOR TOWN PLANNING ENDORSEMENT
B	22.07.2016	TS - ISSUED FOR TOWN PLANNING AMENDMENT



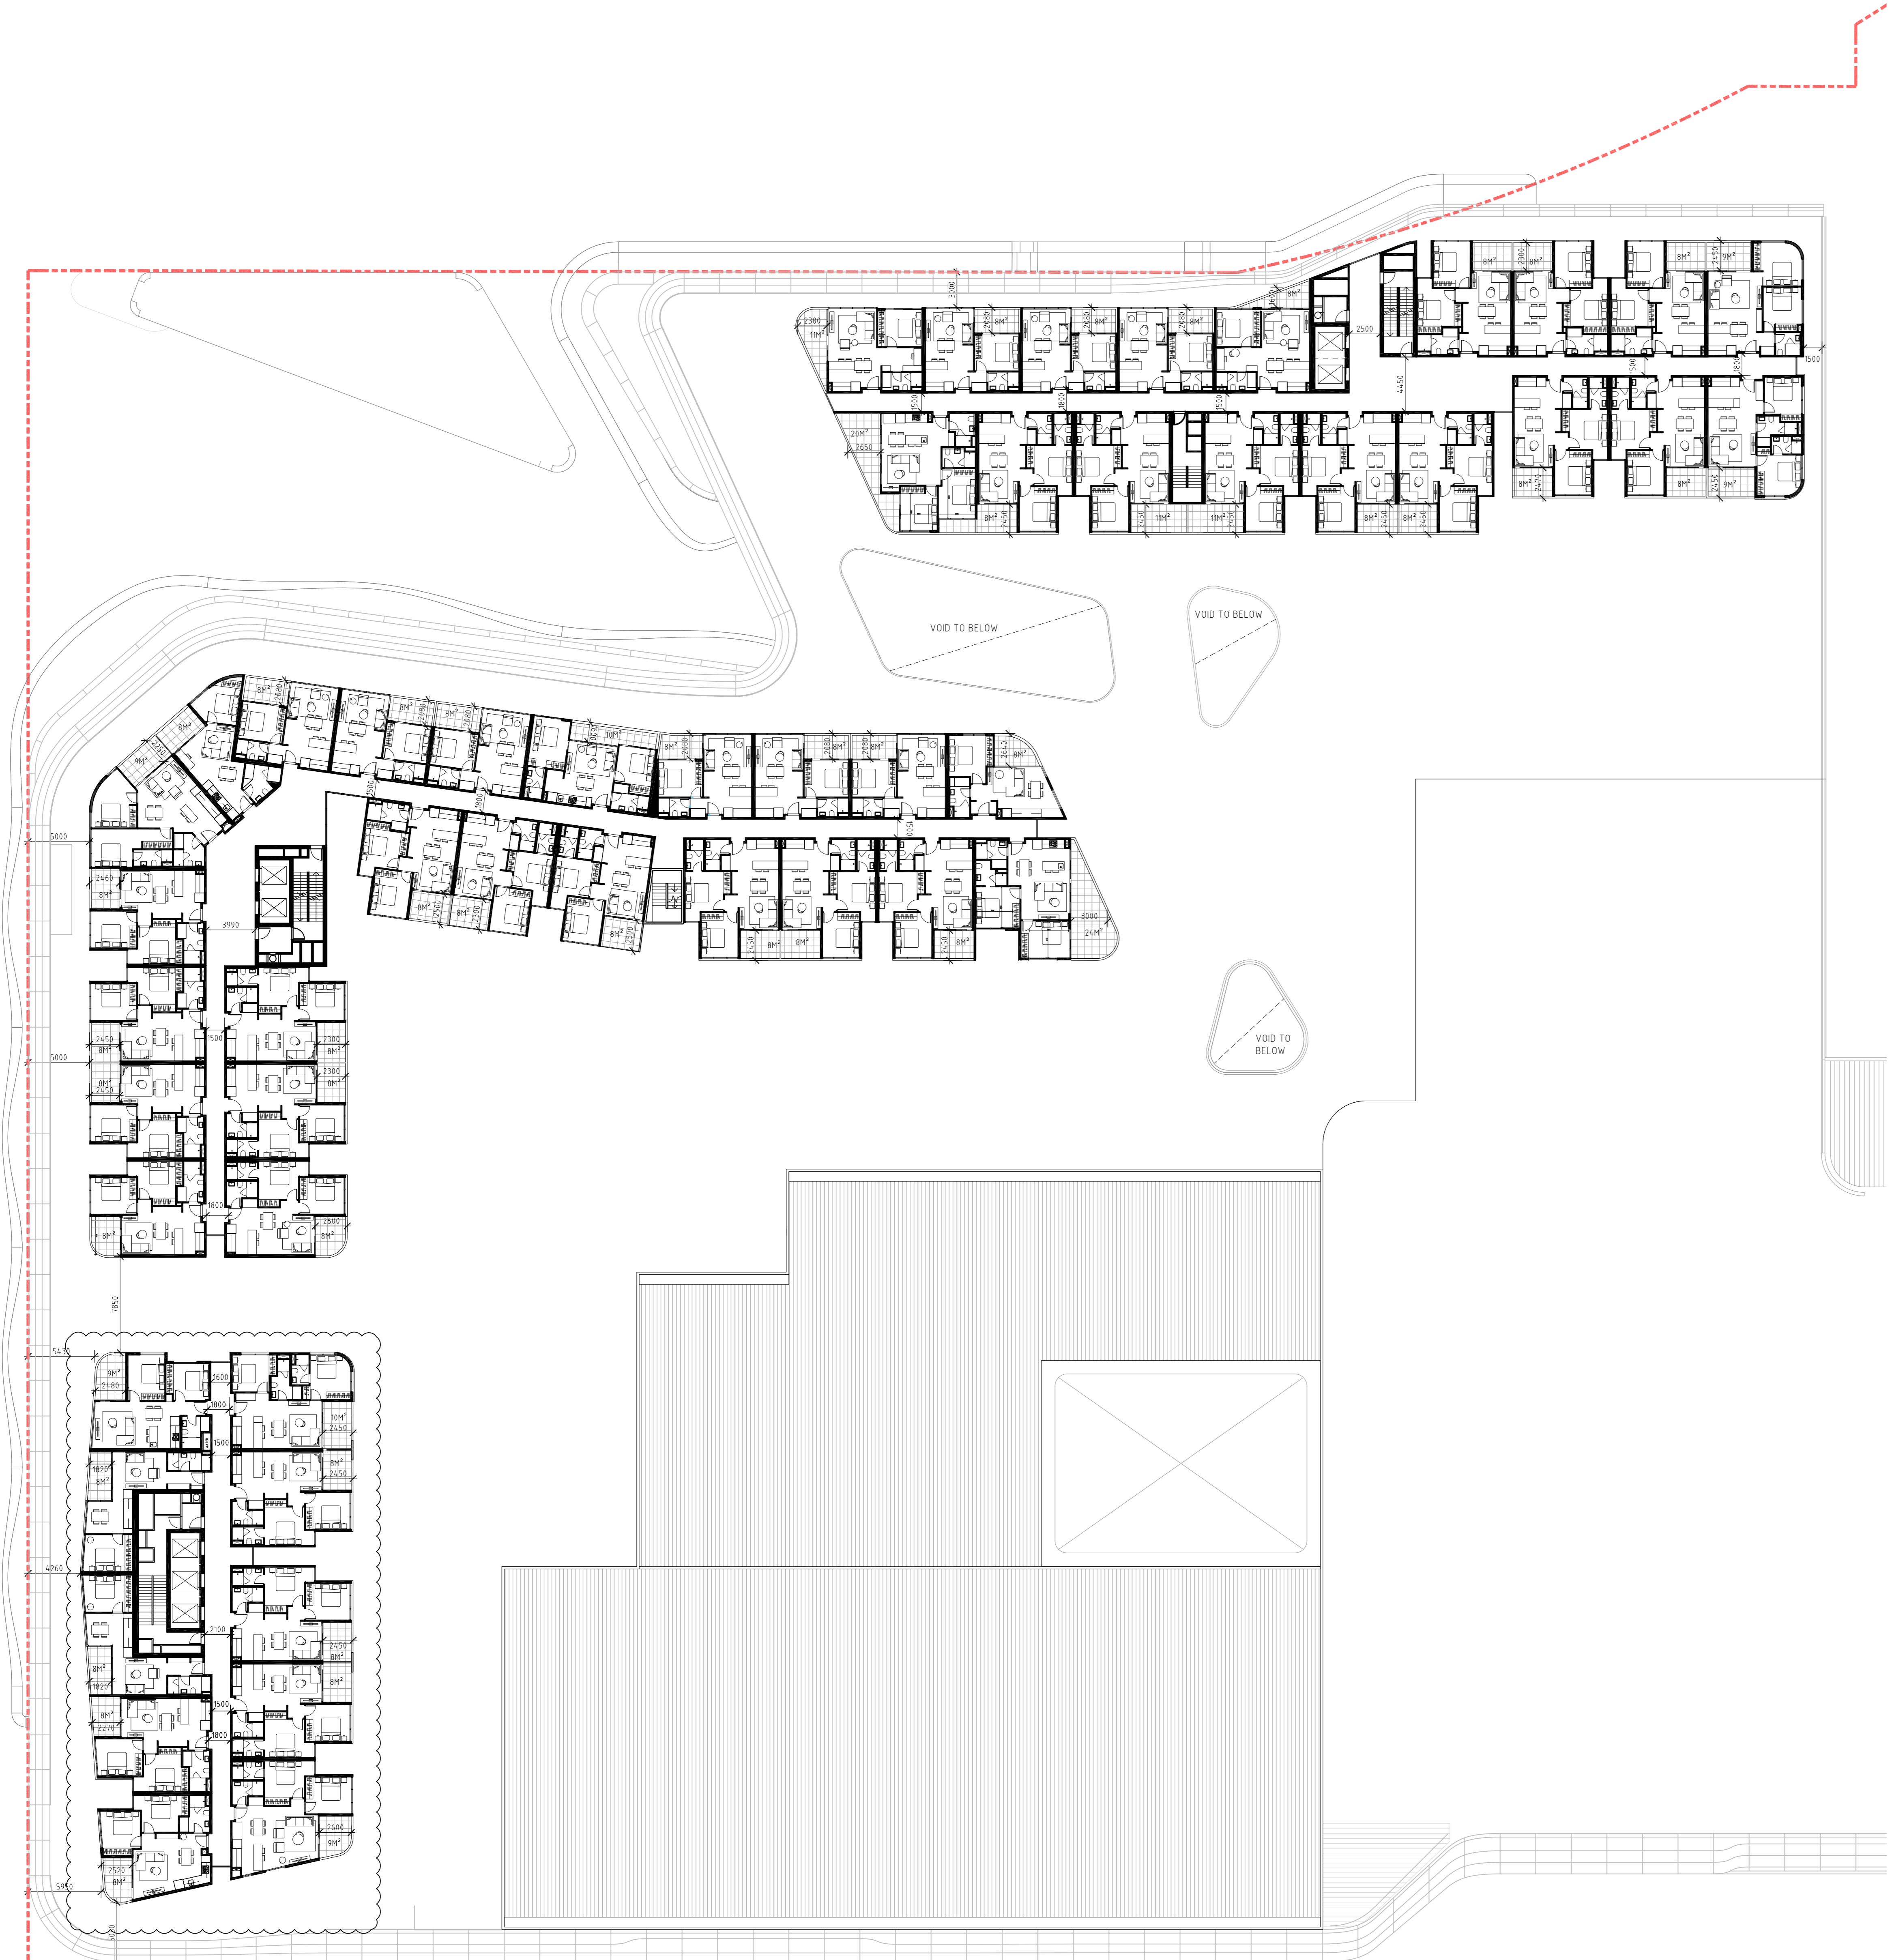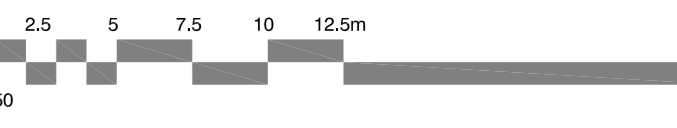


**NOTE: EXISTING TREES NOT SHOWN FOR CLARITY**

LEGEND	
TOWN PLANNING APPLICATION MARCH 2015	TOWN PLANNING ENDORSEMENT JUNE 2016
BASEMENT 03	BASEMENT 03
BASEMENT 02	BASEMENT 02
BASEMENT 01	BASEMENT 01
LEVEL 1	LOWER GROUND
LEVEL 1.5	LOWER GROUND MEZZANINE
LEVEL 2	GROUND LEVEL
LEVEL 3	LEVEL 1
LEVEL 4	LEVEL 2

**GENERAL NOTES**

ECOLOGICALLY SUSTAINABLE DEVELOPMENT (ESD):  
 THE DEVELOPMENT WILL INCORPORATE A RANGE OF ESD AND WATER SENSITIVE URBAN DESIGN (WSUD) INITIATIVES AND MEET OR EXCEED ALL RELEVANT FEDERAL AND STATE GOVERNMENT STATUTORY OBLIGATIONS WITH REGARD TO ENERGY AND WATER CONSERVATION, PASSIVE DESIGN OF BUILDINGS, WASTE MANAGEMENT, WATER SENSITIVE URBAN DESIGN AND MASTER PLANNING PROCESSES. THE PROJECT WILL ALSO BE ASSESSED AGAINST THE GREEN STAR COMMITTES AND GREEN STAR DESIGN AND AS BUILT SUSTAINABILITY TOOLS AND WILL TARGET A FOUR STAR BEST PRACTICE OUTCOME.  
 GREEN STAR COMMITTES MEETS AND EXCEEDS THE SUSTAINABILITY REQUIREMENTS AS OUTLINED IN THE MONASH PLANNING SCHEME.

BALCONY DIVISIONS:  
 INTERFERENCE PRIVACY SCREENS, MINIMUM 1700MM HEIGHT ALUMINIUM FRAMED GLAZED OPAQUE PANEL.

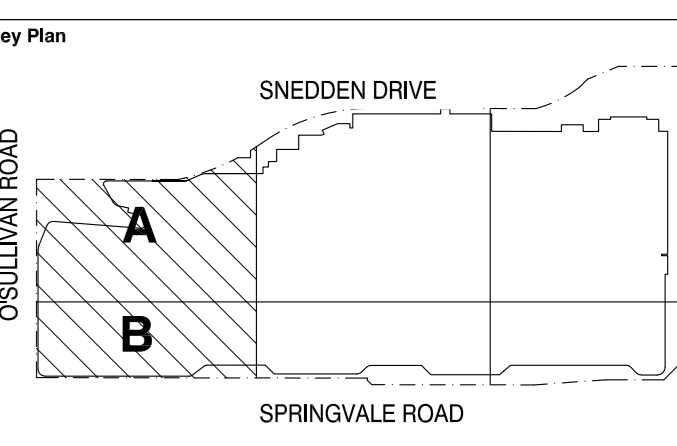



**NHArchitecture**  
 Level 7 Galleria House  
 13-20 Flinders Lane  
 Melbourne, Australia 3000  
 Telephone + 613 9654 4005  
 Facsimile + 613 9654 4008  
 www.nharchitecture.net

Project Name		
THE GLEN SHOPPING CENTRE 235 Springvale Road, Glen Waverley, 3150		
Drawing Name		
PROPOSED LEVEL 05		
Architect	Drawn by	Scale @ A0
PD	TS	1:250
Project Number	Drawing Number	Revision
A120520	TP-35	B

TP-35 LEVEL 05  
 1:250

Rev	Date	Description
A	24.06.2016	TS IV ISSUED FOR TOWN PLANNING ENDORSEMENT
B	22.03.2019	TS IV ISSUED FOR TOWN PLANNING AMENDMENT

Do not scale drawings. Use specific dimensions only. All dimensions must be verified on site before commencing work. This document is for your reference only. All dimensions are shown to the centerline unless otherwise stated. 

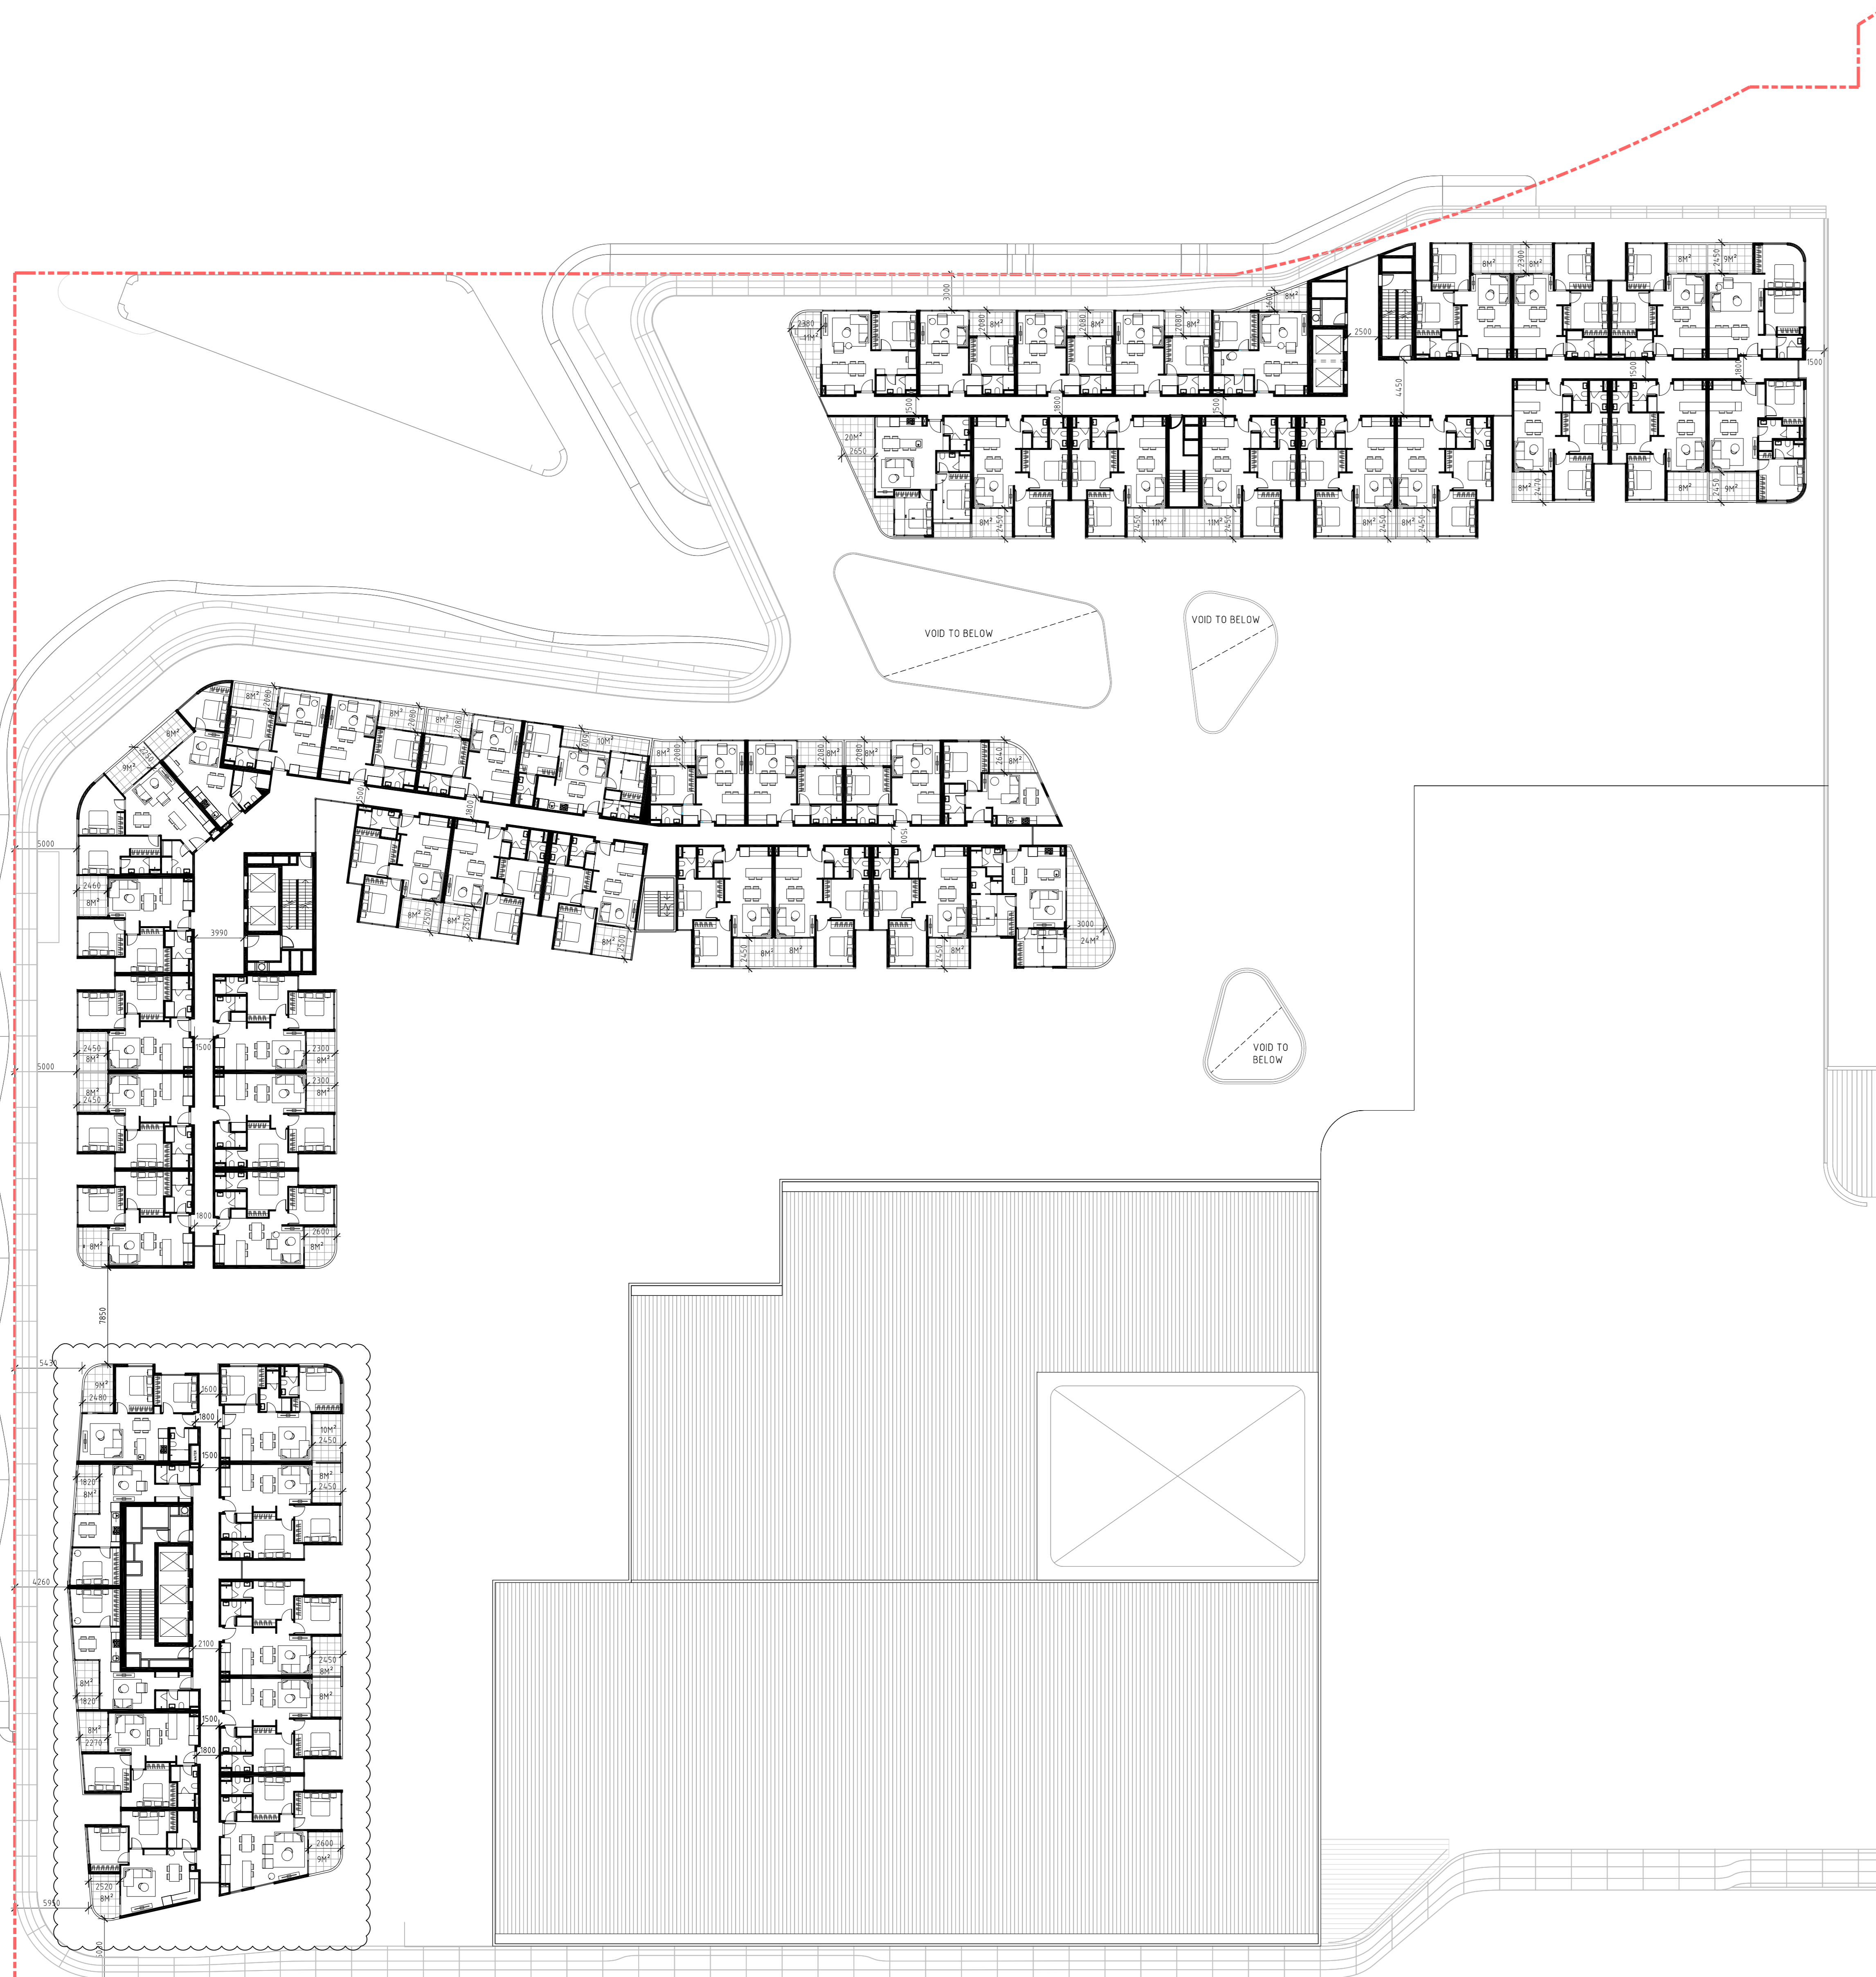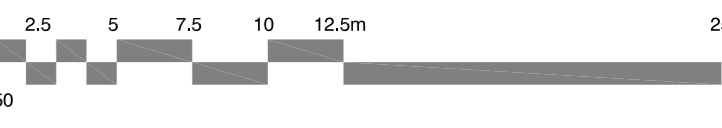


**NOTE: EXISTING TREES NOT SHOWN FOR CLARITY**

LEGEND	
TOWN PLANNING APPLICATION MARCH 2016	TOWN PLANNING ENDORSEMENT JUNE 2016
BASEMENT 03	BASEMENT 03
BASEMENT 02	BASEMENT 02
BASEMENT 01	BASEMENT 01
LEVEL 1	LOWER GROUND
LEVEL 1.5	LOWER GROUND MEZZANINE
LEVEL 2	GROUND LEVEL
LEVEL 3	LEVEL 1
LEVEL 4	LEVEL 2

**GENERAL NOTES**

ECOLOGICALLY SUSTAINABLE DEVELOPMENT (ESD): THE DEVELOPMENT WILL INCORPORATE A RANGE OF ESD AND WATER SENSITIVE URBAN DESIGN (WSUD) INITIATIVES AND MEET OR EXCEED ALL RELEVANT FEDERAL AND STATE GOVERNMENT STATUTORY OBLIGATIONS WITH REGARD TO ENERGY AND WATER CONSERVATION, PASSIVE DESIGN OF BUILDINGS, WASTE MANAGEMENT, WATER SENSITIVE URBAN DESIGN AND MASTER PLANNING PROCESSES. THE PROJECT WILL ALSO BE ASSESSED AGAINST THE GREEN STAR COMMITTES AND GREEN STAR DESIGN AND AS BUILT SUSTAINABILITY TOOLS AND WILL TARGET A FOUR STAR BEST PRACTICE OUTCOME. GREEN STAR COMMITTES MEETS AND EXCEEDS THE SUSTAINABILITY REQUIREMENTS AS OUTLINED IN THE MORASH PLANNING SCHEME.

BALCONY DIVISIONS: INTERFERENCE PRIVACY SCREENS, MINIMUM 1700MM HEIGHT ALUMINIUM FRAMED GLAZED OPAQUE PANEL.

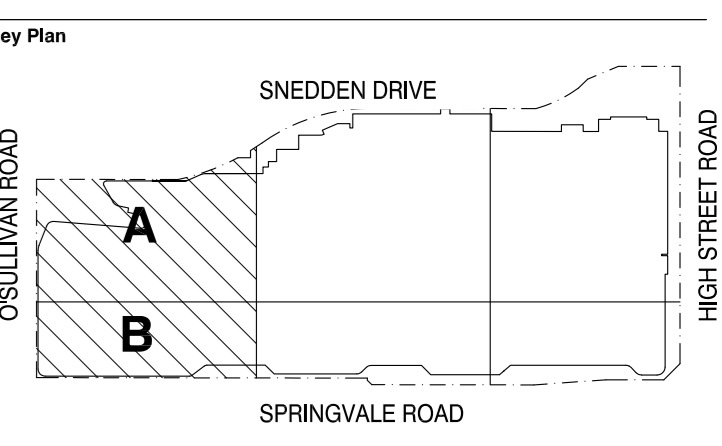

Client: VICINITY CENTRES

Consultant: **NHArchitecture**  
Level 7 Galleria House  
13-20 Finbars Lane  
Melbourne, Australia 3000  
Telephone: +613 9634 4005  
Facsimile: +613 9634 4009  
www.nharchitecture.net

**TOWN PLANNING**

TP-36 LEVEL 06  
1:250



Project Name: **THE GLEN SHOPPING CENTRE**  
235 Springvale Road, Glen Waverley, 3150

Drawing Name: **PROPOSED LEVEL 06**

Architect	Drawn By	Scale @
PD	TS	1:250
Project Number	Drawing Number	Revision
A120520	TP-36	B

Rev	Date	Description
A	24.06.2016	TS - ISSUED FOR TOWN PLANNING ENDORSEMENT
B	22.07.2016	TS - ISSUED FOR TOWN PLANNING AMENDMENT

Do not scale drawings. Use figure dimensions only. All dimensions must be verified on site before construction commences. This document is for the use of the client and is not to be used for any other purpose. It is the responsibility of the client to ensure that the information provided in this document is accurate and up to date. 

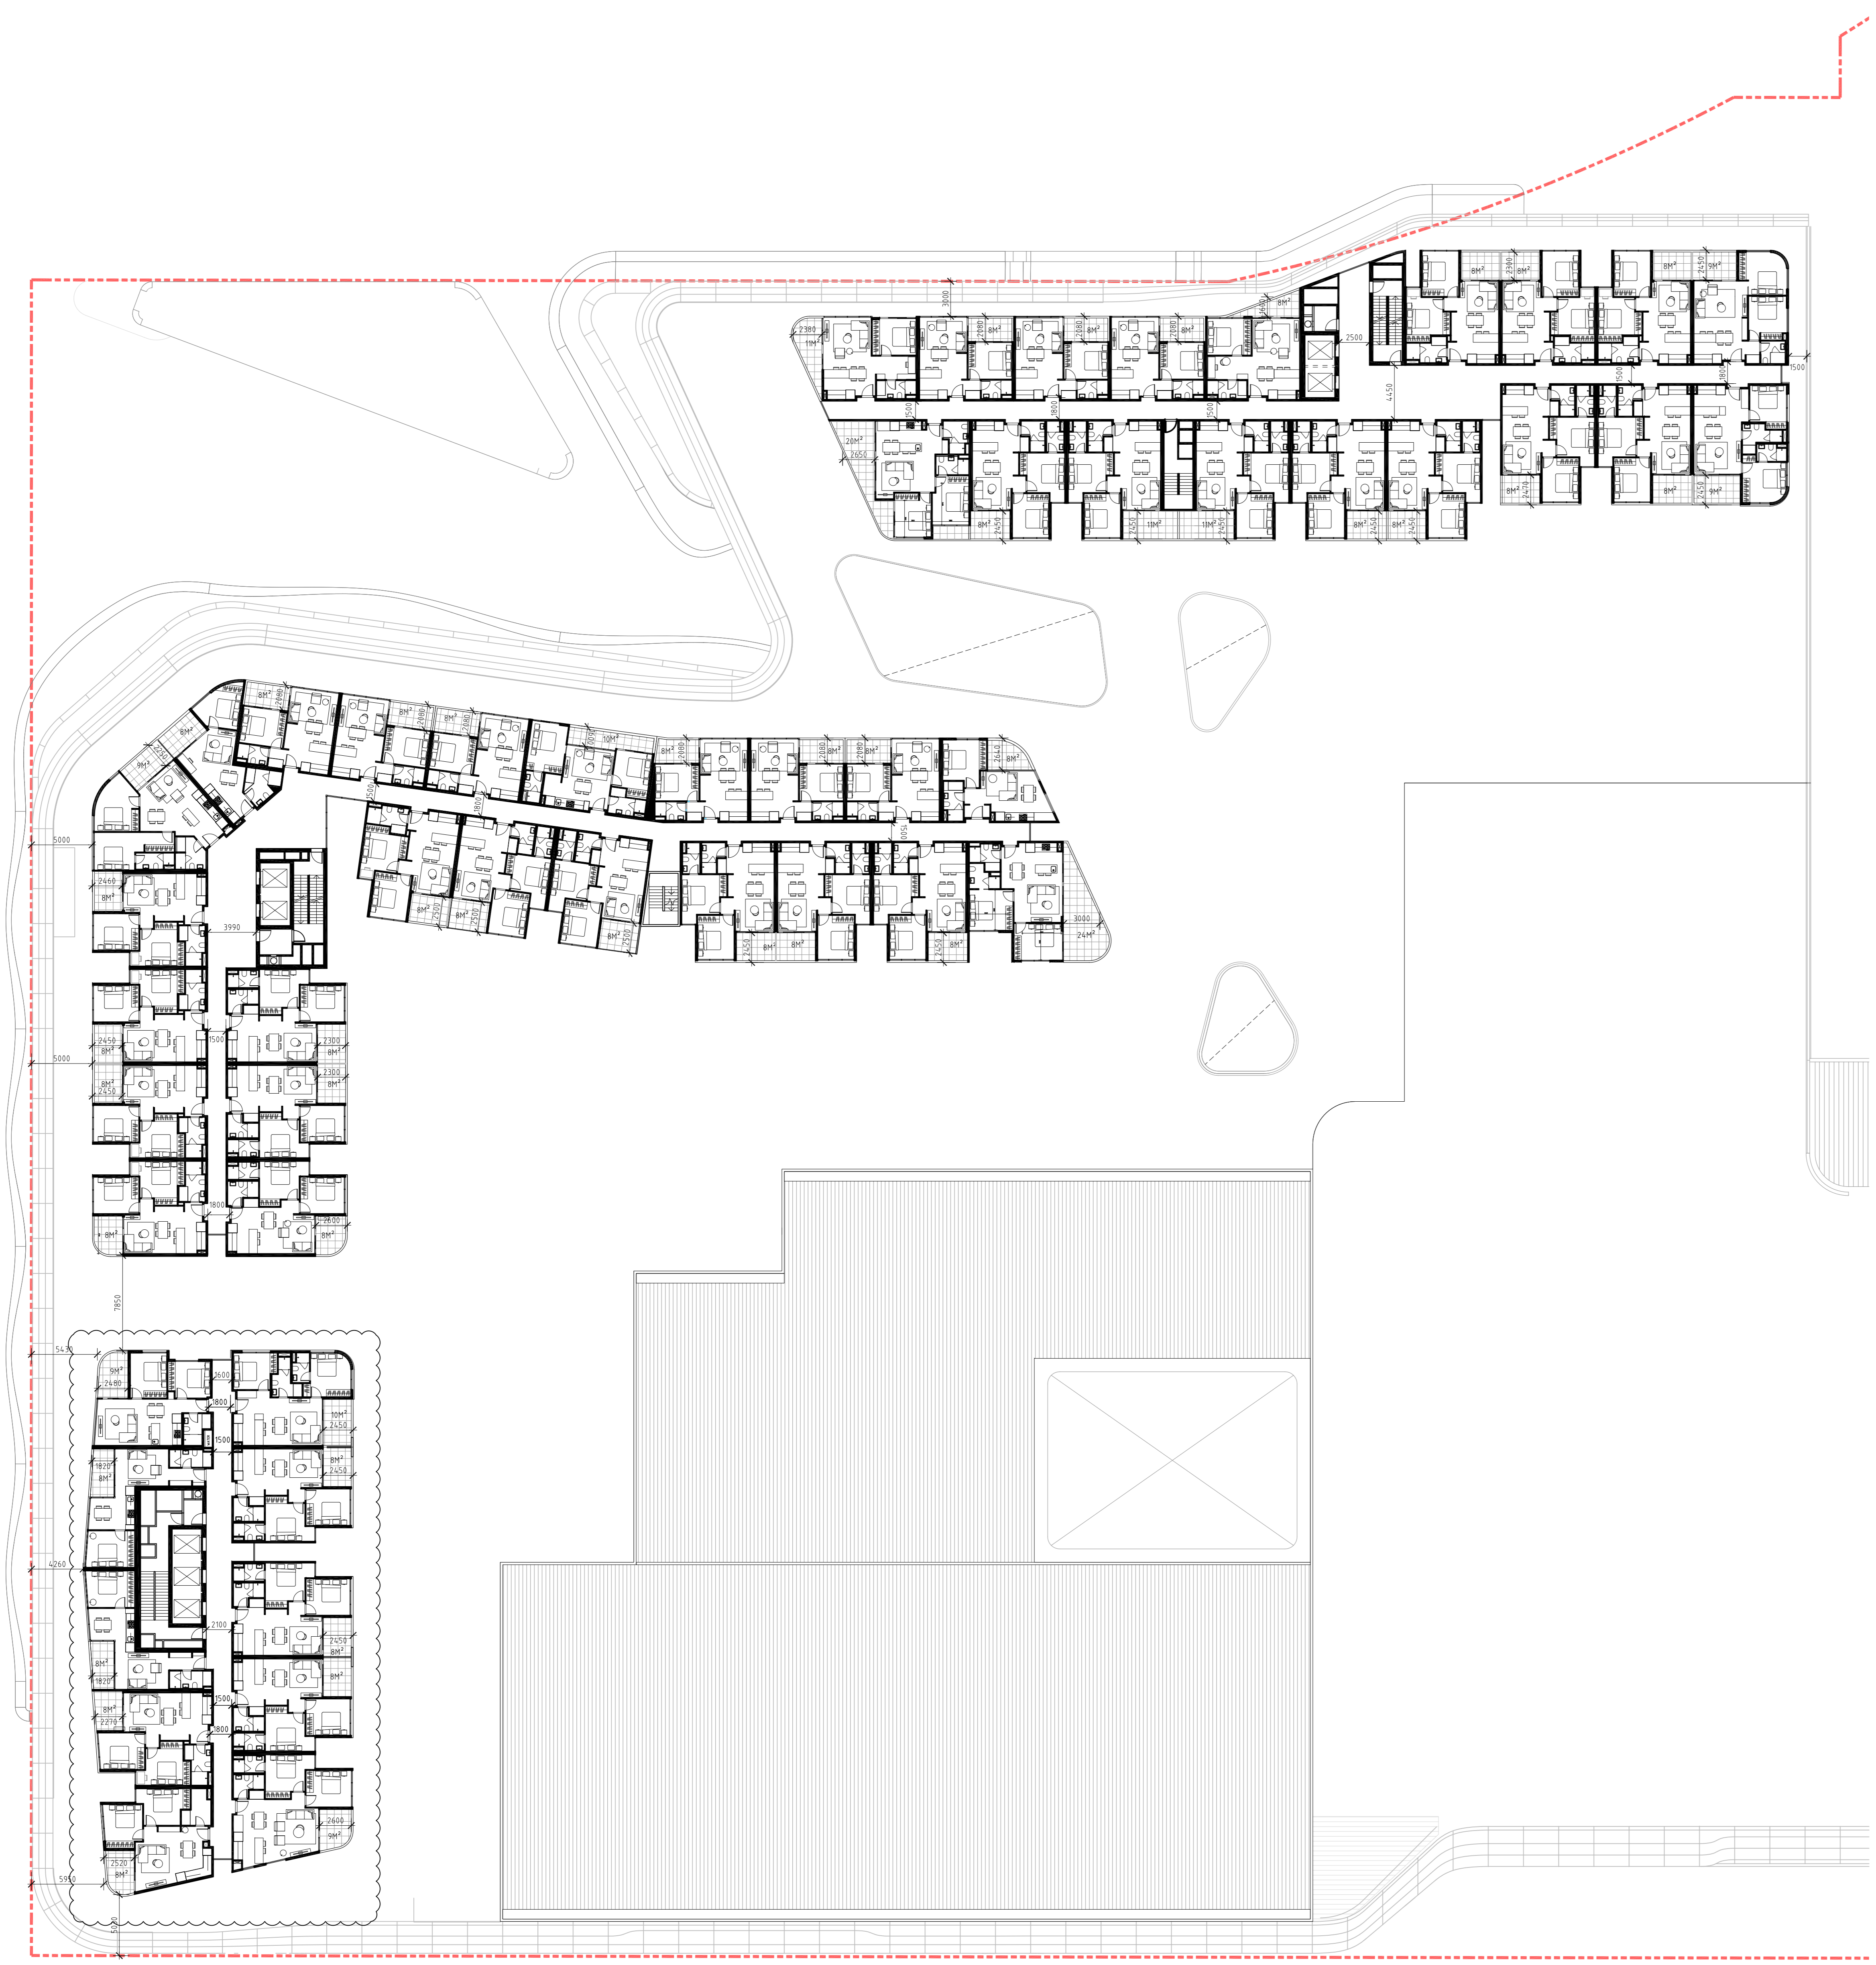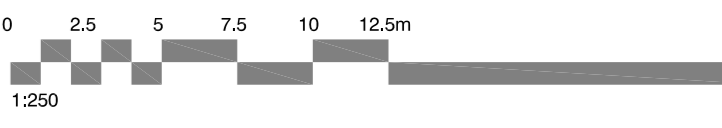


**NOTE: EXISTING TREES NOT SHOWN FOR CLARITY**

LEGEND	
TOWN PLANNING APPLICATION MARCH 2016	TOWN PLANNING ENDORSEMENT JUNE 2016
BASEMENT 03	BASEMENT 03
BASEMENT 02	BASEMENT 02
BASEMENT 01	BASEMENT 01
LEVEL 1	LOWER GROUND
LEVEL 1.5	LOWER GROUND MEZZANINE
LEVEL 2	GROUND LEVEL
LEVEL 3	LEVEL 1
LEVEL 4	LEVEL 2

**GENERAL NOTES**

ECOLOGICALLY SUSTAINABLE DEVELOPMENT (ESD):  
 THE DEVELOPMENT WILL INCORPORATE A RANGE OF ESD AND WATER SENSITIVE URBAN DESIGN (WSUD) INITIATIVES AND MEET OR EXCEED ALL RELEVANT FEDERAL AND STATE GOVERNMENT STATUTORY OBLIGATIONS WITH REGARD TO ENERGY AND WATER CONSERVATION, PASSIVE DESIGN OF BUILDINGS, WASTE MANAGEMENT, WATER SENSITIVE URBAN DESIGN AND MASTER PLANNING PROCESSES. THE PROJECT WILL ALSO BE ASSESSED AGAINST THE GREEN STAR CRITERIA AND GREEN STAR DESIGN AND AS BUILT SUSTAINABILITY TOOLS AND WILL TARGET A FOUR STAR (BEST PRACTICE) OUTCOME.  
 GREEN STAR CRITERIA: MEETS AND EXCEEDS THE SUSTAINABILITY REQUIREMENTS AS OUTLINED IN THE MONASH PLANNING SCHEME.

BALCONY DIVISIONS:  
 INTERFERENCE PRIVACY SCREENS, MINIMUM 1700MM HEIGHT ALUMINIUM FRAMED GLAZED OPAQUE PANEL.

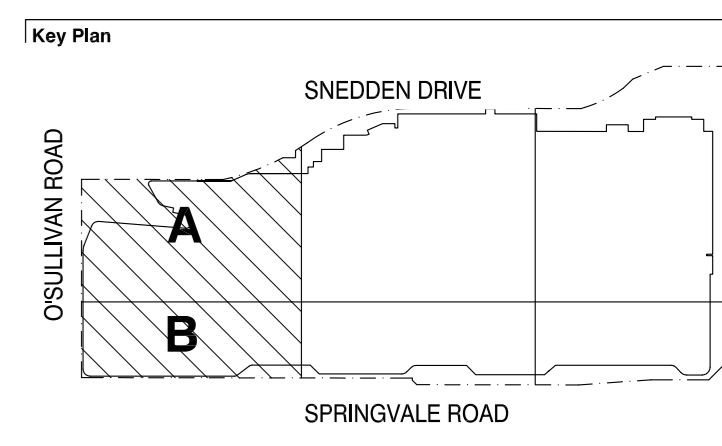

Client: **VICINITY CENTRES**

Consultant: **NHArchitecture**  
 Level 7 Galleria House  
 13-20 Flinders Lane  
 Melbourne, Australia 3000  
 Telephone +613 9654 4005  
 Facsimile +613 9654 4008  
 www.nharchitecture.net

Project Name: **THE GLEN SHOPPING CENTRE**  
 235 Springvale Road, Glen Waverley, 3150


Drawing Name: **PROPOSED LEVEL 07**

Architect	Drawn By	Scale @ A0
PD	TS	1:250
Project Number	Drawing Number	Revision
A120520	TP-37	B

TP-37 LEVEL 07  
 1:250

Rev	Date	Description
A	24.06.2016	TS IV ISSUED FOR TOWN PLANNING ENDORSEMENT
B	28.07.2016	TS IV ISSUED FOR TOWN PLANNING ENDORSEMENT


Do not scale drawings. Use figure dimensions only. All dimensions must be verified on site before construction. This document is to be used in conjunction with all relevant specifications and standards. 

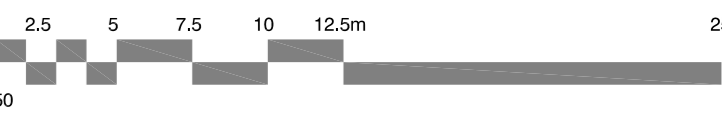

**NOTE: EXISTING TREES NOT SHOWN FOR CLARITY**

LEGEND	
TOWN PLANNING APPLICATION MARCH 2016	TOWN PLANNING ENDORSEMENT JUNE 2016
BASEMENT 03	BASEMENT 03
BASEMENT 02	BASEMENT 02
BASEMENT 01	BASEMENT 01
LEVEL 1	LOWER GROUND
LEVEL 1.5	LOWER GROUND MEZZANINE
LEVEL 2	GROUND LEVEL
LEVEL 3	LEVEL 1
LEVEL 4	LEVEL 2

**GENERAL NOTES**  
 ECOLOGICALLY SUSTAINABLE DEVELOPMENT (ESD)  
 THE DEVELOPMENT WILL INCORPORATE A RANGE OF ESD AND WATER SENSITIVE URBAN DESIGN (WSUD) INITIATIVES AND MEET OR EXCEED ALL RELEVANT FEDERAL AND STATE GOVERNMENT STATUTORY OBLIGATIONS WITH REGARD TO ENERGY AND WATER CONSERVATION, PASSIVE DESIGN OF BUILDINGS, WASTE MANAGEMENT, WATER SENSITIVE URBAN DESIGN AND MASTER PLANNING PROCESSES. THE PROJECT WILL ALSO BE ASSESSED AGAINST THE GREEN STAR CRITERIA AND GREEN STAR DESIGN AND AS BUILT SUSTAINABILITY TOOLS AND WILL TARGET A FOUR STAR BEST PRACTICE OUTCOME.  
 GREEN STAR CRITERIA: MEETS AND EXCEEDS THE SUSTAINABILITY REQUIREMENTS AS OUTLINED IN THE MONASH PLANNING SCHEME.  
 BALCONY DIVISIONS:  
 INTERFERENCE PRIVACY SCREENS, MINIMUM 1700MM HEIGHT ALUMINIUM FRAMED GLAZED OPaque PANEL.

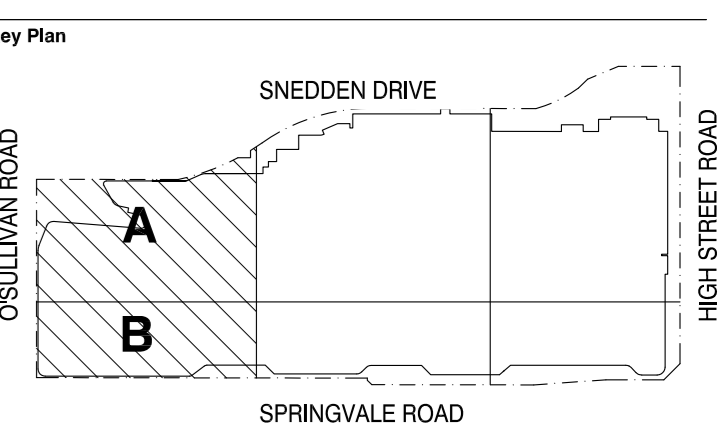

Client: **VICINITY CENTRES**

Consultant: **NHArchitecture** Level 7 Galleria House, 13-20 Flinders Lane, Melbourne, Australia 3000  
 Telephone +613 9654 4000, Facsimile +613 9654 4003, www.nharchitecture.net

Project Name: **THE GLEN SHOPPING CENTRE**  
 235 Springvale Road, Glen Waverley, 3150

Drawing Name		
PROPOSED LEVEL 08		
Architect	Drawn By	Scale @
PD	TS	1:250
Project Number	Drawing Number	Revision
A120520	TP-38	B


LEVEL 08  
 TP-38 1:250

08  
 10  
 11



Rev	Date	Description
A	24.06.2016	TS - IV ISSUED FOR TOWN PLANNING ENDORSEMENT
B	28.07.2016	TS - IV ISSUED FOR TOWN PLANNING ENDORSEMENT



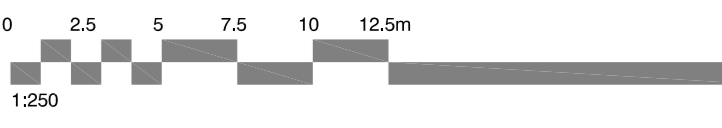


**NOTE: EXISTING TREES NOT SHOWN FOR CLARITY**

LEGEND	
TOWN PLANNING APPLICATION MARCH 2015	TOWN PLANNING ENDORSEMENT JUNE 2016
BASEMENT 03	BASEMENT 03
BASEMENT 02	BASEMENT 02
BASEMENT 01	BASEMENT 01
LEVEL 1	LOWER GROUND
LEVEL 1.5	LOWER GROUND MEZZANINE
LEVEL 2	GROUND LEVEL
LEVEL 3	LEVEL 1
LEVEL 4	LEVEL 2

**GENERAL NOTES**

ECOLOGICALLY SUSTAINABLE DEVELOPMENT (ESD):  
 THE DEVELOPMENT WILL INCORPORATE A RANGE OF ESD AND WATER SENSITIVE URBAN DESIGN (WSUD) INITIATIVES AND MEET OR EXCEED ALL RELEVANT FEDERAL AND STATE GOVERNMENT STATUTORY OBLIGATIONS WITH REGARD TO ENERGY AND WATER CONSERVATION, PASSIVE DESIGN OF BUILDINGS, WASTE MANAGEMENT, WATER SENSITIVE URBAN DESIGN AND MASTER PLANNING PROCESSES. THE PROJECT WILL ALSO BE ASSESSED AGAINST THE GREEN STAR CRITERIA AND GREEN STAR DESIGN AND AS BUILT SUSTAINABILITY TOOLS AND WILL TARGET A FOUR STAR (BEST PRACTICE) OUTCOME.  
 GREEN STAR COMMITMENTS: MEETS AND EXCEEDS THE SUSTAINABILITY REQUIREMENTS AS OUTLINED IN THE MONASH PLANNING SCHEME.

BALCONY DIVISIONS:  
 INTERFERENCE PRIVACY SCREENS, MINIMUM 1700MM HEIGHT ALUMINIUM FRAMED GLAZED OPAQUE PANEL.

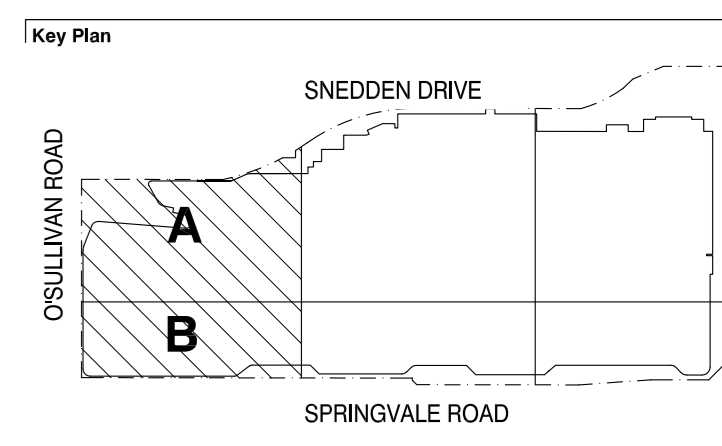

Client: **VICINITY CENTRES**

Consultant: **NHArchitecture**  
 Level 7 Galleria House  
 13-20 Flinders Lane  
 Melbourne, Australia 3000  
 Telephone +613 9654 4000  
 Facsimile +613 9654 4000  
 www.nharchitecture.net

Project Name: **THE GLEN SHOPPING CENTRE**  
 235 Springvale Road, Glen Waverley, 3150



Drawing Name: **PROPOSED LEVEL 09**

Architect	Drawn By	Scale @ A0
PD	TS	1:250
Project Number	Drawing Number	Revision
A120520	TP-39	B

TP-39 LEVEL 09  
 1:250

Rev	Date	Description
A	24.06.2016	TS - IV ISSUED FOR TOWN PLANNING ENDORSEMENT
B	28.07.2016	TS - IV ISSUED FOR TOWN PLANNING ENDORSEMENT

Do not scale drawings. Use figure dimensions only. All dimensions must be verified on site before construction. This document is for your reference only. All dimensions must be verified on site before construction.

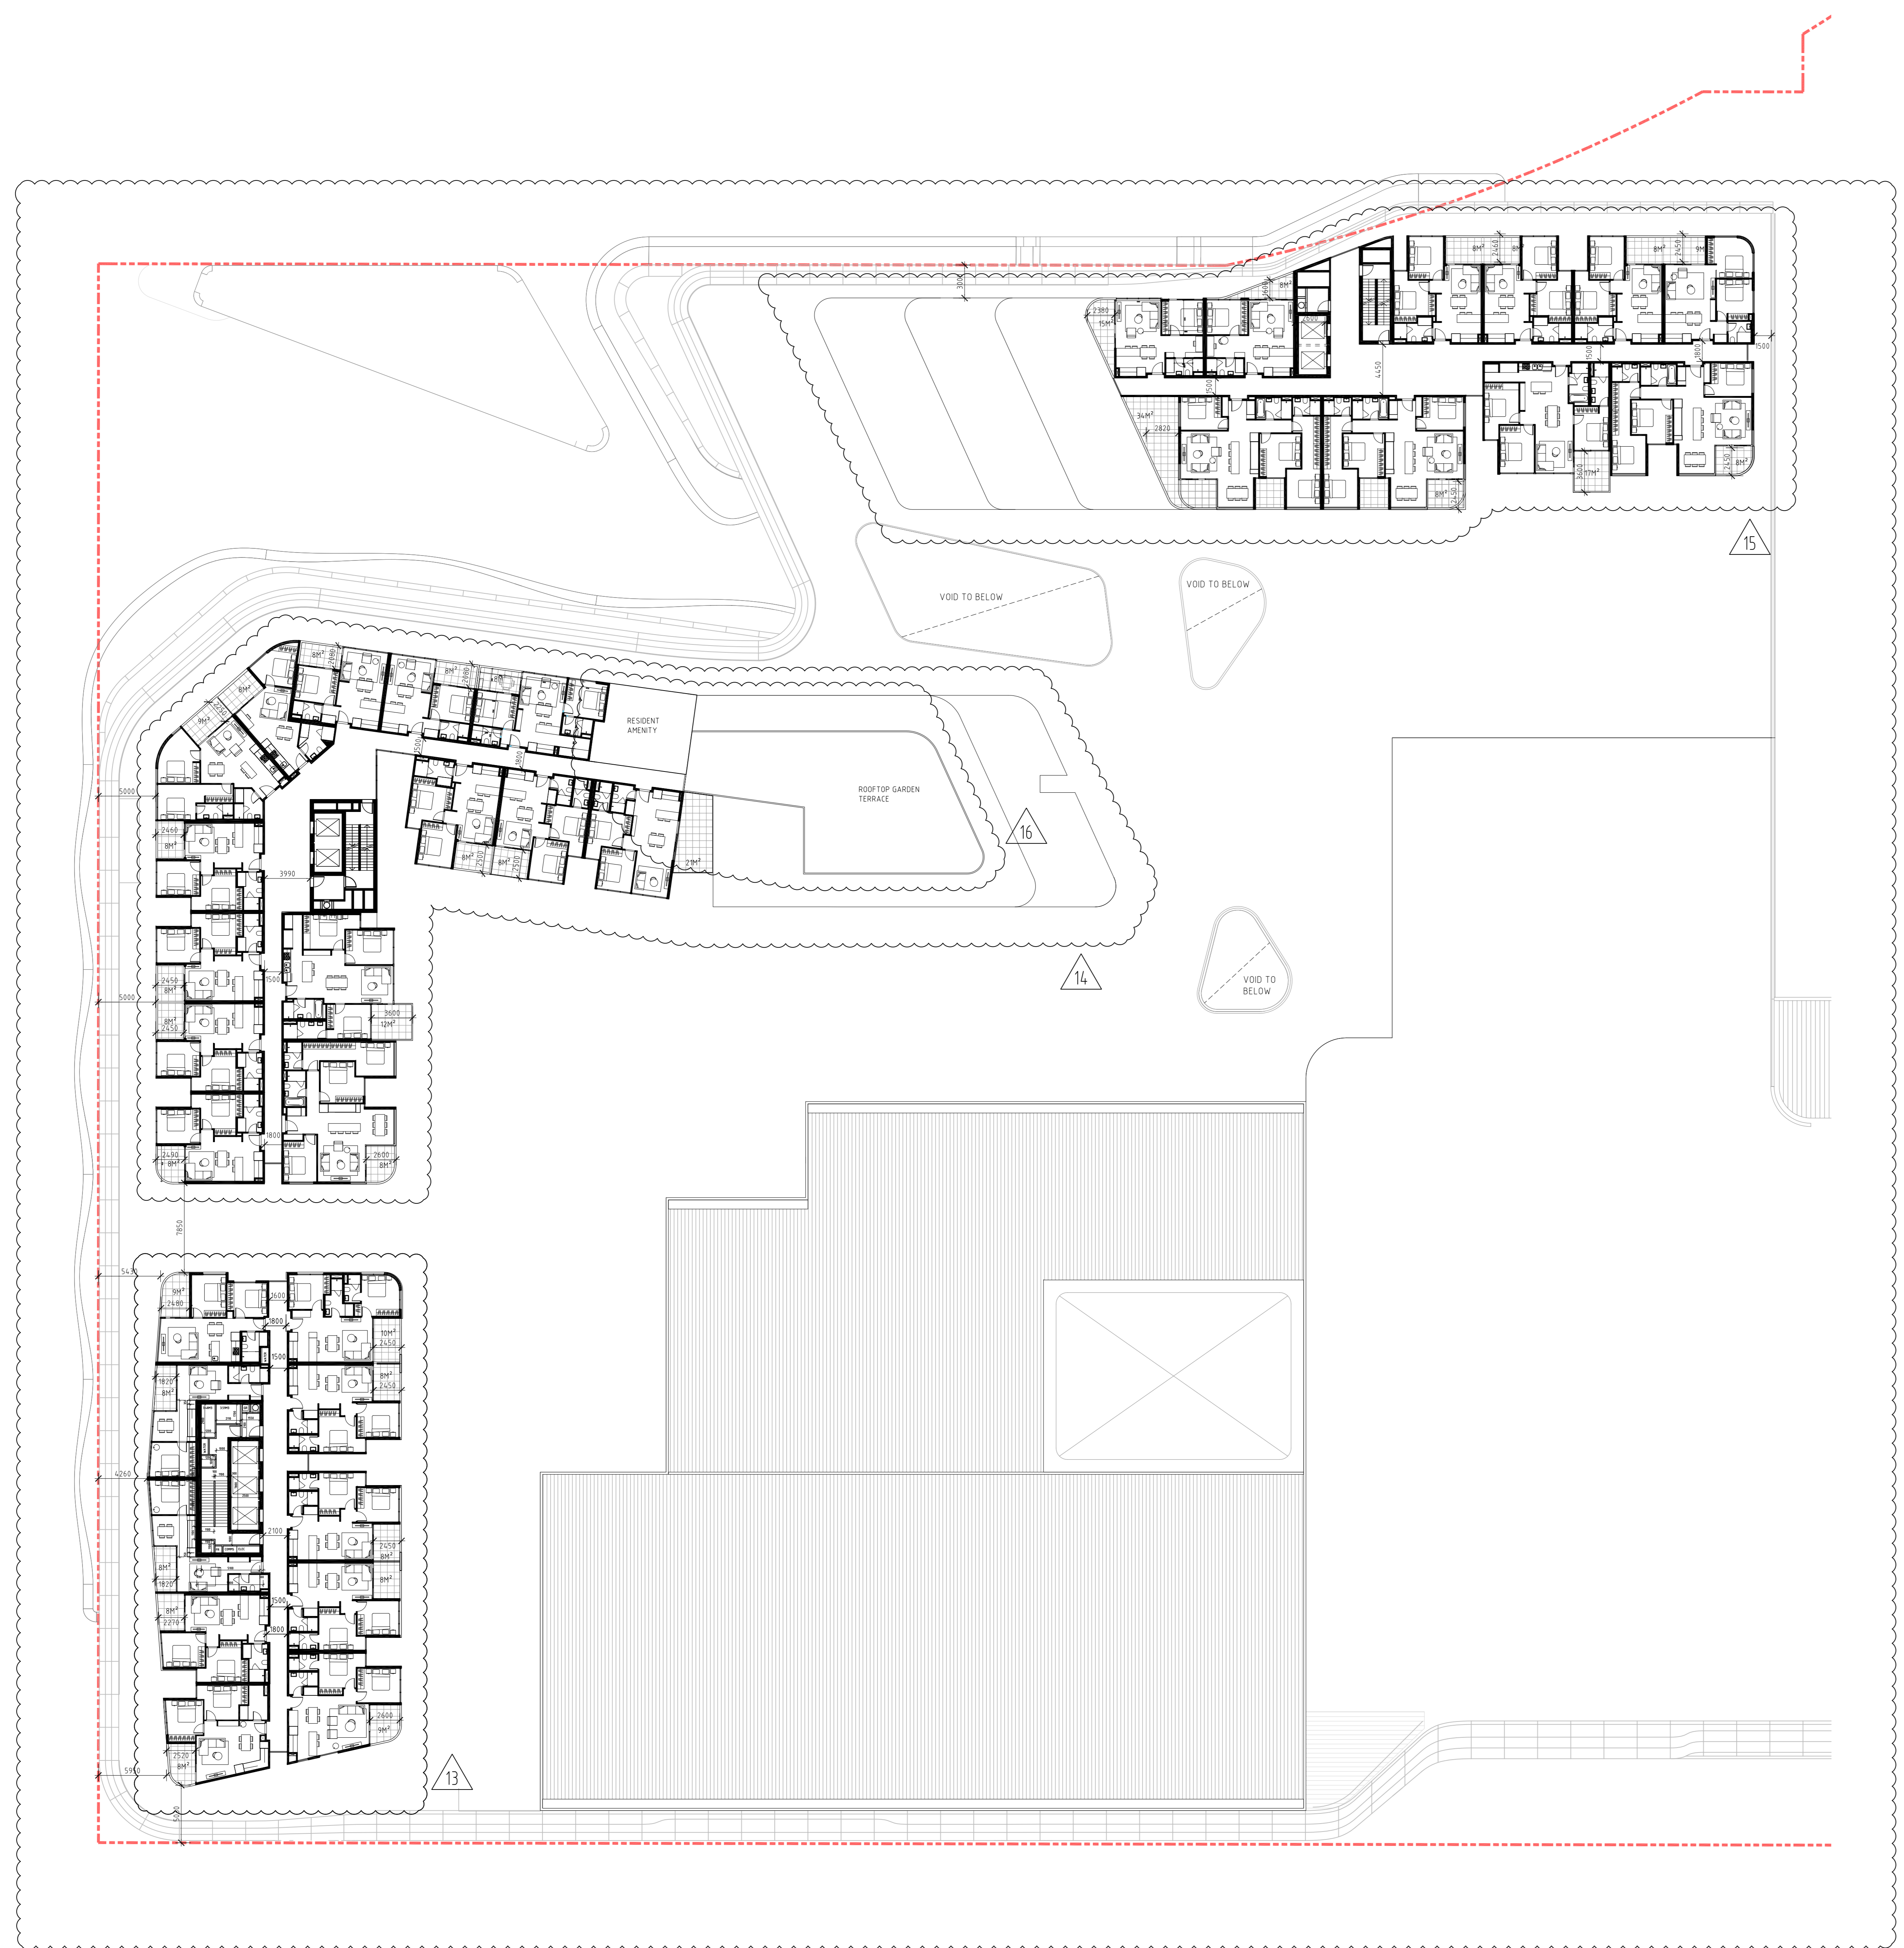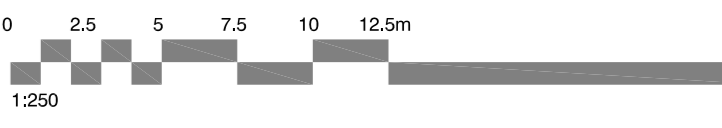


**NOTE: EXISTING TREES NOT SHOWN FOR CLARITY**

LEGEND	
TOWN PLANNING APPLICATION MARCH 2015	TOWN PLANNING ENDORSEMENT JUNE 2016
BASEMENT 03	BASEMENT 03
BASEMENT 02	BASEMENT 02
BASEMENT 01	BASEMENT 01
LEVEL 1	LOWER GROUND
LEVEL 1.5	LOWER GROUND MEZZANINE
LEVEL 2	GROUND LEVEL
LEVEL 3	LEVEL 1
LEVEL 4	LEVEL 2

**GENERAL NOTES**

ECOLOGICALLY SUSTAINABLE DEVELOPMENT (ESD):  
 THE DEVELOPMENT WILL INCORPORATE A RANGE OF ESD AND WATER SENSITIVE URBAN DESIGN (WSUD) INITIATIVES AND MEET OR EXCEED ALL RELEVANT FEDERAL AND STATE GOVERNMENT STATUTORY OBLIGATIONS WITH REGARD TO ENERGY AND WATER CONSERVATION, PASSIVE DESIGN OF BUILDINGS, WASTE MANAGEMENT, WATER SENSITIVE URBAN DESIGN AND MASTER PLANNING PROCESSES. THE PROJECT WILL ALSO BE ASSESSED AGAINST THE GREEN STAR CRITERIA AND GREEN STAR DESIGN AND AS BUILT SUSTAINABILITY TOOLS AND WILL TARGET A FOUR STAR (BEST PRACTICE) OUTCOME.  
 GREEN STAR COMMITMENTS: MEETS AND EXCEEDS THE SUSTAINABILITY REQUIREMENTS AS OUTLINED IN THE MONASH PLANNING SCHEME.  
 BALCONY DIVISIONS:  
 INTERFERENCE PRIVACY SCREENS, MINIMUM 1700MM HEIGHT ALUMINIUM FRAMED GLAZED OPaque PANEL.

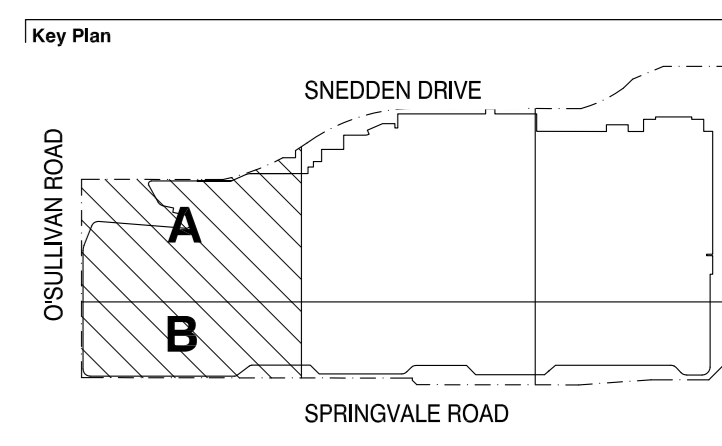

Client: **VICINITY CENTRES**

Consultant: **NHArchitecture**  
 Level 7 Galleria House  
 13-20 Flinders Lane  
 Melbourne, Australia 3000  
 Telephone +613 9654 4000  
 Facsimile +613 9654 4000  
 www.nharchitecture.net

Project Name: **THE GLEN SHOPPING CENTRE**  
 235 Springvale Road, Glen Waverley, 3150



Drawing Name: **PROPOSED LEVEL 10**

Architect	Drawn By	Scale @ A0
PD	TS	1:250
Project Number	Drawing Number	Revision
A120520	TP-40	B

 1:250

Rev	Date	Description
A	25.06.2018	15 JV ISSUED FOR TOWN PLANNING ENDORSEMENT
B	28.07.2018	15 JV ISSUED FOR TOWN PLANNING AMENDMENT

Do not scale drawings. Use figured dimensions only. All dimensions must be verified on site before construction work. The standard measurement units are metric and dimensions are in millimetres unless otherwise stated. 

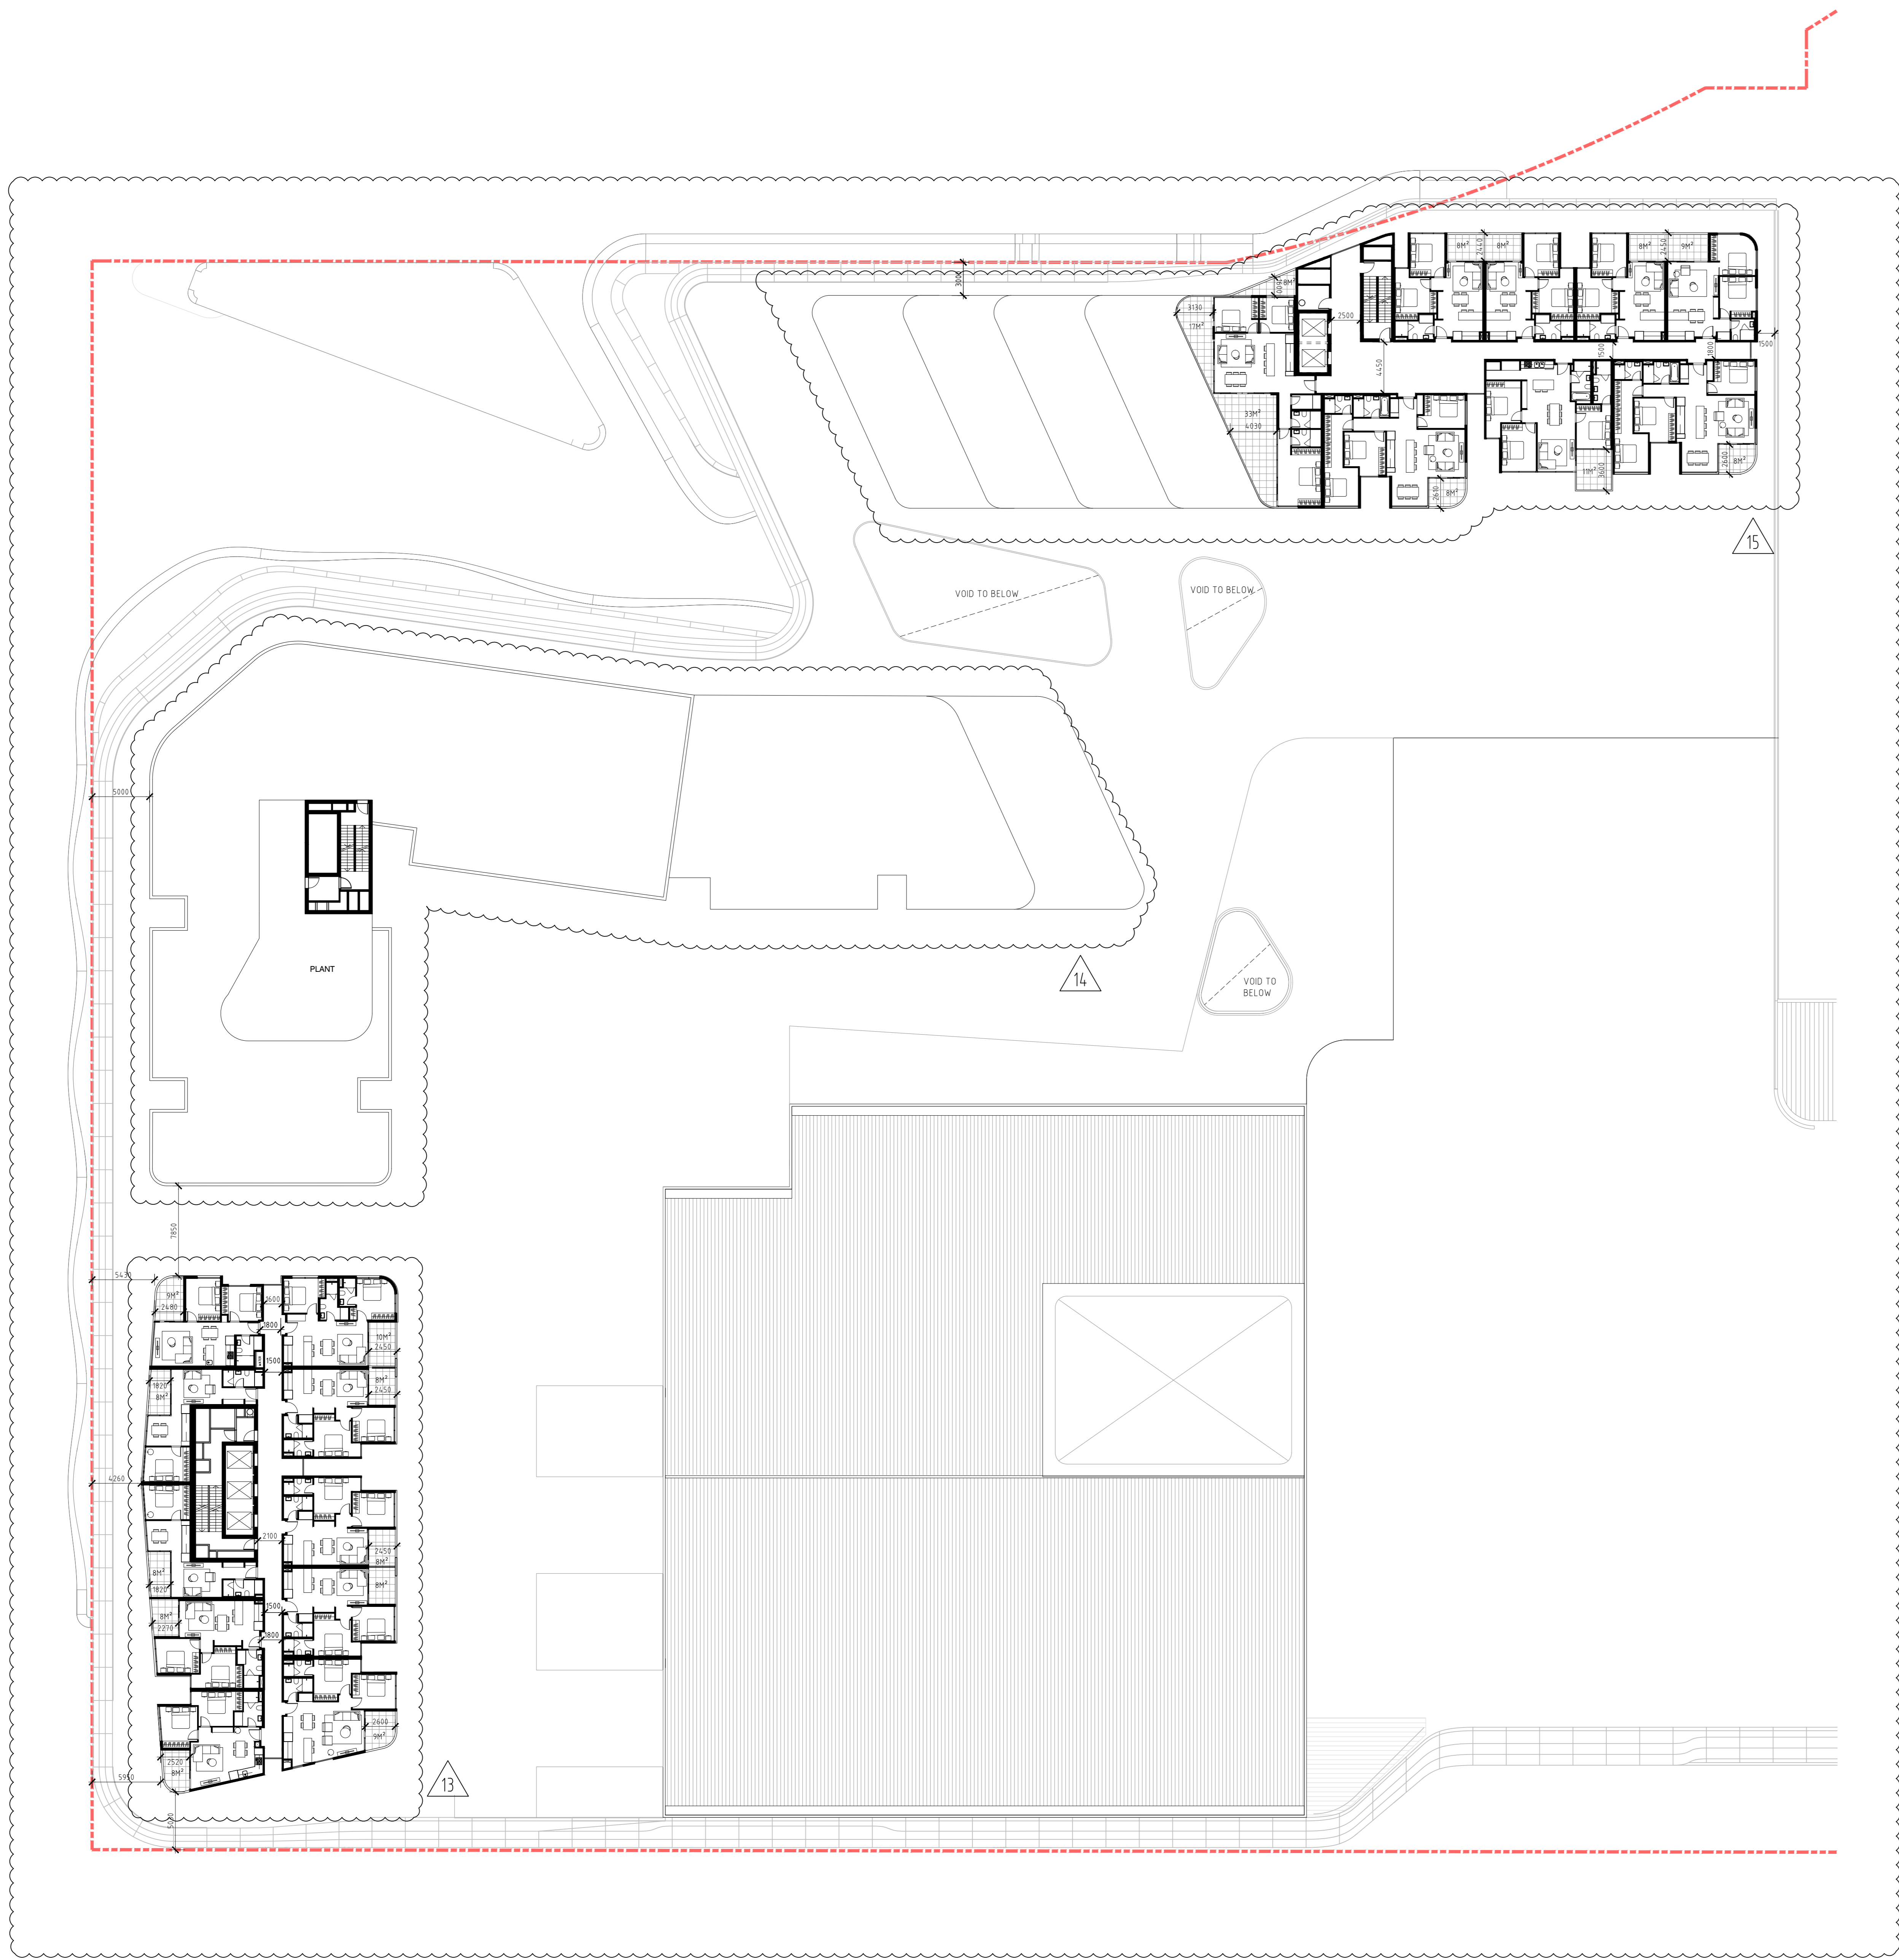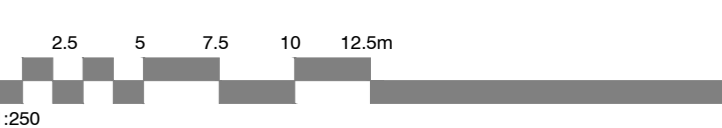


NOTE: EXISTING TREES NOT SHOWN FOR CLARITY

**LEGEND**

TOWN PLANNING APPLICATION MARCH 2018	TOWN PLANNING ENDORSEMENT JUNE 2018
BASEMENT G2	BASEMENT G2
BASEMENT G1	BASEMENT G1
BASEMENT G0	BASEMENT G0
LEVEL 1	LOWER GROUND
LEVEL 1.5	LOWER GROUND MEZZANINE
LEVEL 2	GROUND LEVEL
LEVEL 3	LEVEL 1
LEVEL 4	LEVEL 2

**GENERAL NOTES**

ECOLOGICALLY SUSTAINABLE DEVELOPMENT (ESD):  
 THE DEVELOPMENT WILL INCORPORATE A RANGE OF ESD AND WATER SENSITIVE URBAN DESIGN (WSUD) INITIATIVES AND MEET OR EXCEED ALL RELEVANT FEDERAL AND STATE GOVERNMENT STATUTORY OBLIGATIONS WITH REGARD TO ENERGY AND WATER CONSERVATION, PASSIVE DESIGN OF BUILDINGS, WASTE MANAGEMENT, WATER SENSITIVE URBAN DESIGN AND WATER PLANNING PROCESSES. THE PROJECT WILL ALSO BE ASSESSED AGAINST THE GREEN STAR COMMITMENT AND GREEN STAR DESIGN AND AS BUILT SUSTAINABILITY TOOLS AND WILL TARGET A FOUR STAR (BEST PRACTICE) OUTCOME.  
 BALCONY DIVISIONS:  
 INTERFERENCE PRIVACY SCREENS MINIMUM 1700MM HEIGHT ALUMINIUM FRAMED GLAZED OPAQUE PANEL.

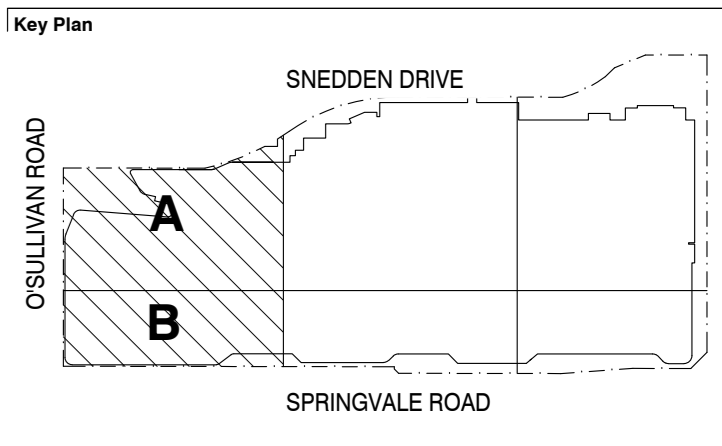

Client  
 NHArchitecture  
 Level 7 Carrons House  
 12/20 Flinders Lane  
 Melbourne, Australia 3000  
 Telephone +613 9654 4056  
 Facsimile +613 9654 4028  
 www.nharchitecture.com.au

Project Name  
**THE GLEN SHOPPING CENTRE**  
 235 Springvale Road, Glen Waverley, 3150



Drawing Name  
**PROPOSED LEVEL 11**

Architect	Drawn By	Scale @ A0
PD	TS	1 : 250
Project Number	Drawing Number	Revision
A120520	TP-41	B

LEVEL 11  
 TP-41  
 1 : 250

Rev	Date	Description
A	25.06.2018	15 JV ISSUED FOR TOWN PLANNING ENDORSEMENT
B	28.07.2018	15 JV ISSUED FOR TOWN PLANNING ENDORSEMENT



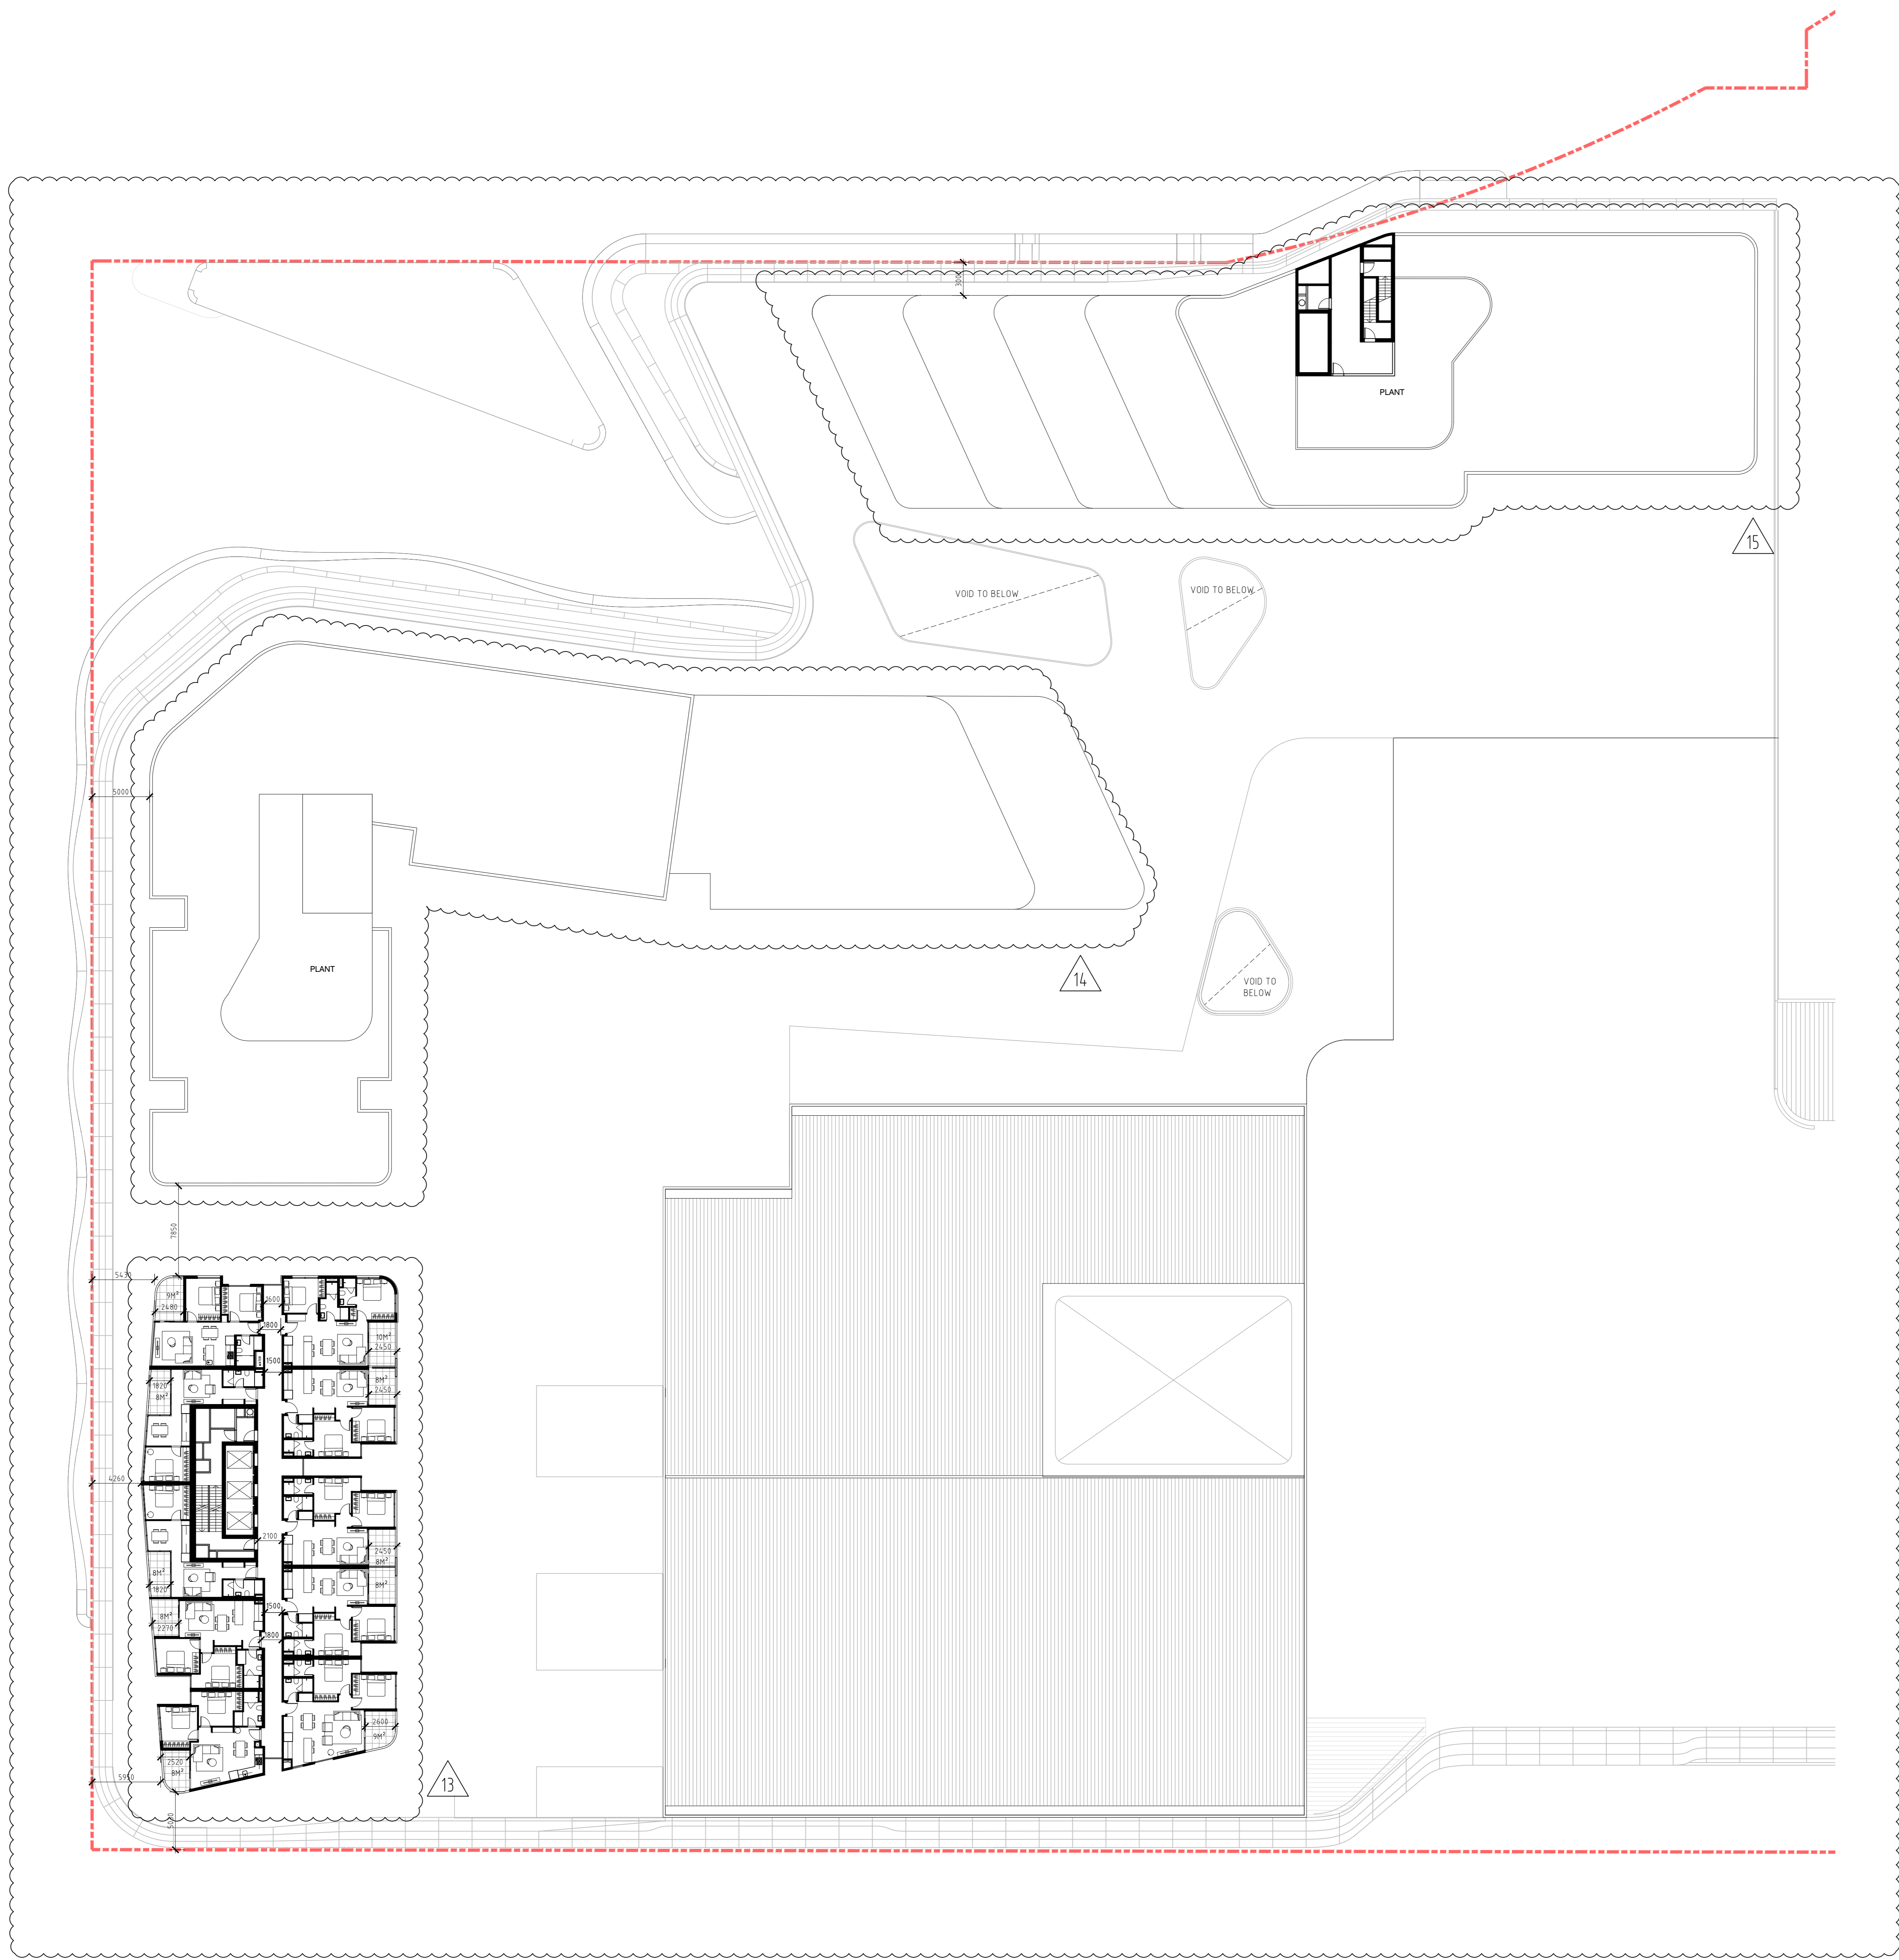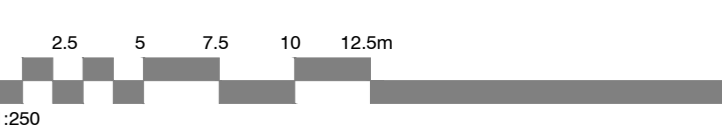


NOTE: EXISTING TREES NOT SHOWN FOR CLARITY

LEGEND	
TOWN PLANNING APPLICATION MARCH 2018	TOWN PLANNING ENDORSEMENT JUNE 2018
BASEMENT G2	BASEMENT G2
BASEMENT G2	BASEMENT G2
BASEMENT G1	BASEMENT G1
LEVEL 1	LOWER GROUND
LEVEL 1.5	LOWER GROUND MEZZANINE
LEVEL 2	GROUND LEVEL
LEVEL 3	LEVEL 1
LEVEL 4	LEVEL 2

**GENERAL NOTES**

ECOLOGICALLY SUSTAINABLE DEVELOPMENT (ESD):  
 THE DEVELOPMENT WILL INCORPORATE A RANGE OF ESD AND WATER SENSITIVE URBAN DESIGN (WSUD) INITIATIVES AND MEET OR EXCEED ALL RELEVANT FEDERAL AND STATE GOVERNMENT STATUTORY OBLIGATIONS WITH REGARD TO ENERGY AND WATER CONSERVATION, PASSIVE DESIGN OF BUILDINGS, WASTE MANAGEMENT, WATER SENSITIVE URBAN DESIGN AND WATER PLANNING PROCESSES. THE PROJECT WILL ALSO BE ASSESSED AGAINST THE GREEN STAR COMMITMENT AND GREEN STAR DESIGN AND AS BUILT SUSTAINABILITY TOOLS AND WILL TARGET A FOUR STAR (BEST PRACTICE) OUTCOME.  
 GREEN STAR COMMITMENT MEETS AND EXCEEDS THE SUSTAINABILITY REQUIREMENTS AS OUTLINED IN THE MOWSHAW PLANNING SCHEME.

BALCONY DIVISIONS:  
 INTERFERENCE PRIVACY SCREENS MINIMUM 1700MM HEIGHT ALUMINIUM FRAMED GLAZED OPAQUE PANEL.

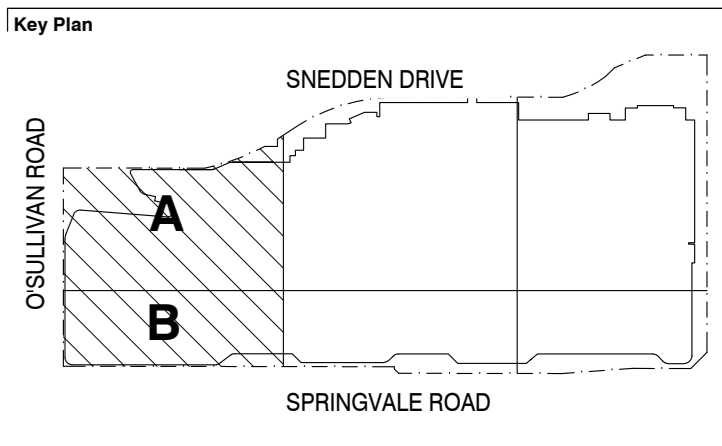

Client  
 Consultant  
**NHArchitecture** Level 7 Carrons House  
 12/20 Flinders Lane  
 Melbourne, Australia 3000  
 Telephone +613 9654 4056  
 Facsimile +613 9654 4028  
 www.nharchitecture.com.au



Project Name  
**THE GLEN SHOPPING CENTRE**  
 235 Springvale Road, Glen Waverley, 3150

Drawing Name  
**TP-42 - PROPOSED LEVEL 12 - 15**

Architect	Drawn By	Scale @ A0
PD	TS	1 : 250
Project Number	Drawing Number	Revision
A120520	TP-42	B

LEVEL 12 TO 18  
 TP-42  
 1 : 250



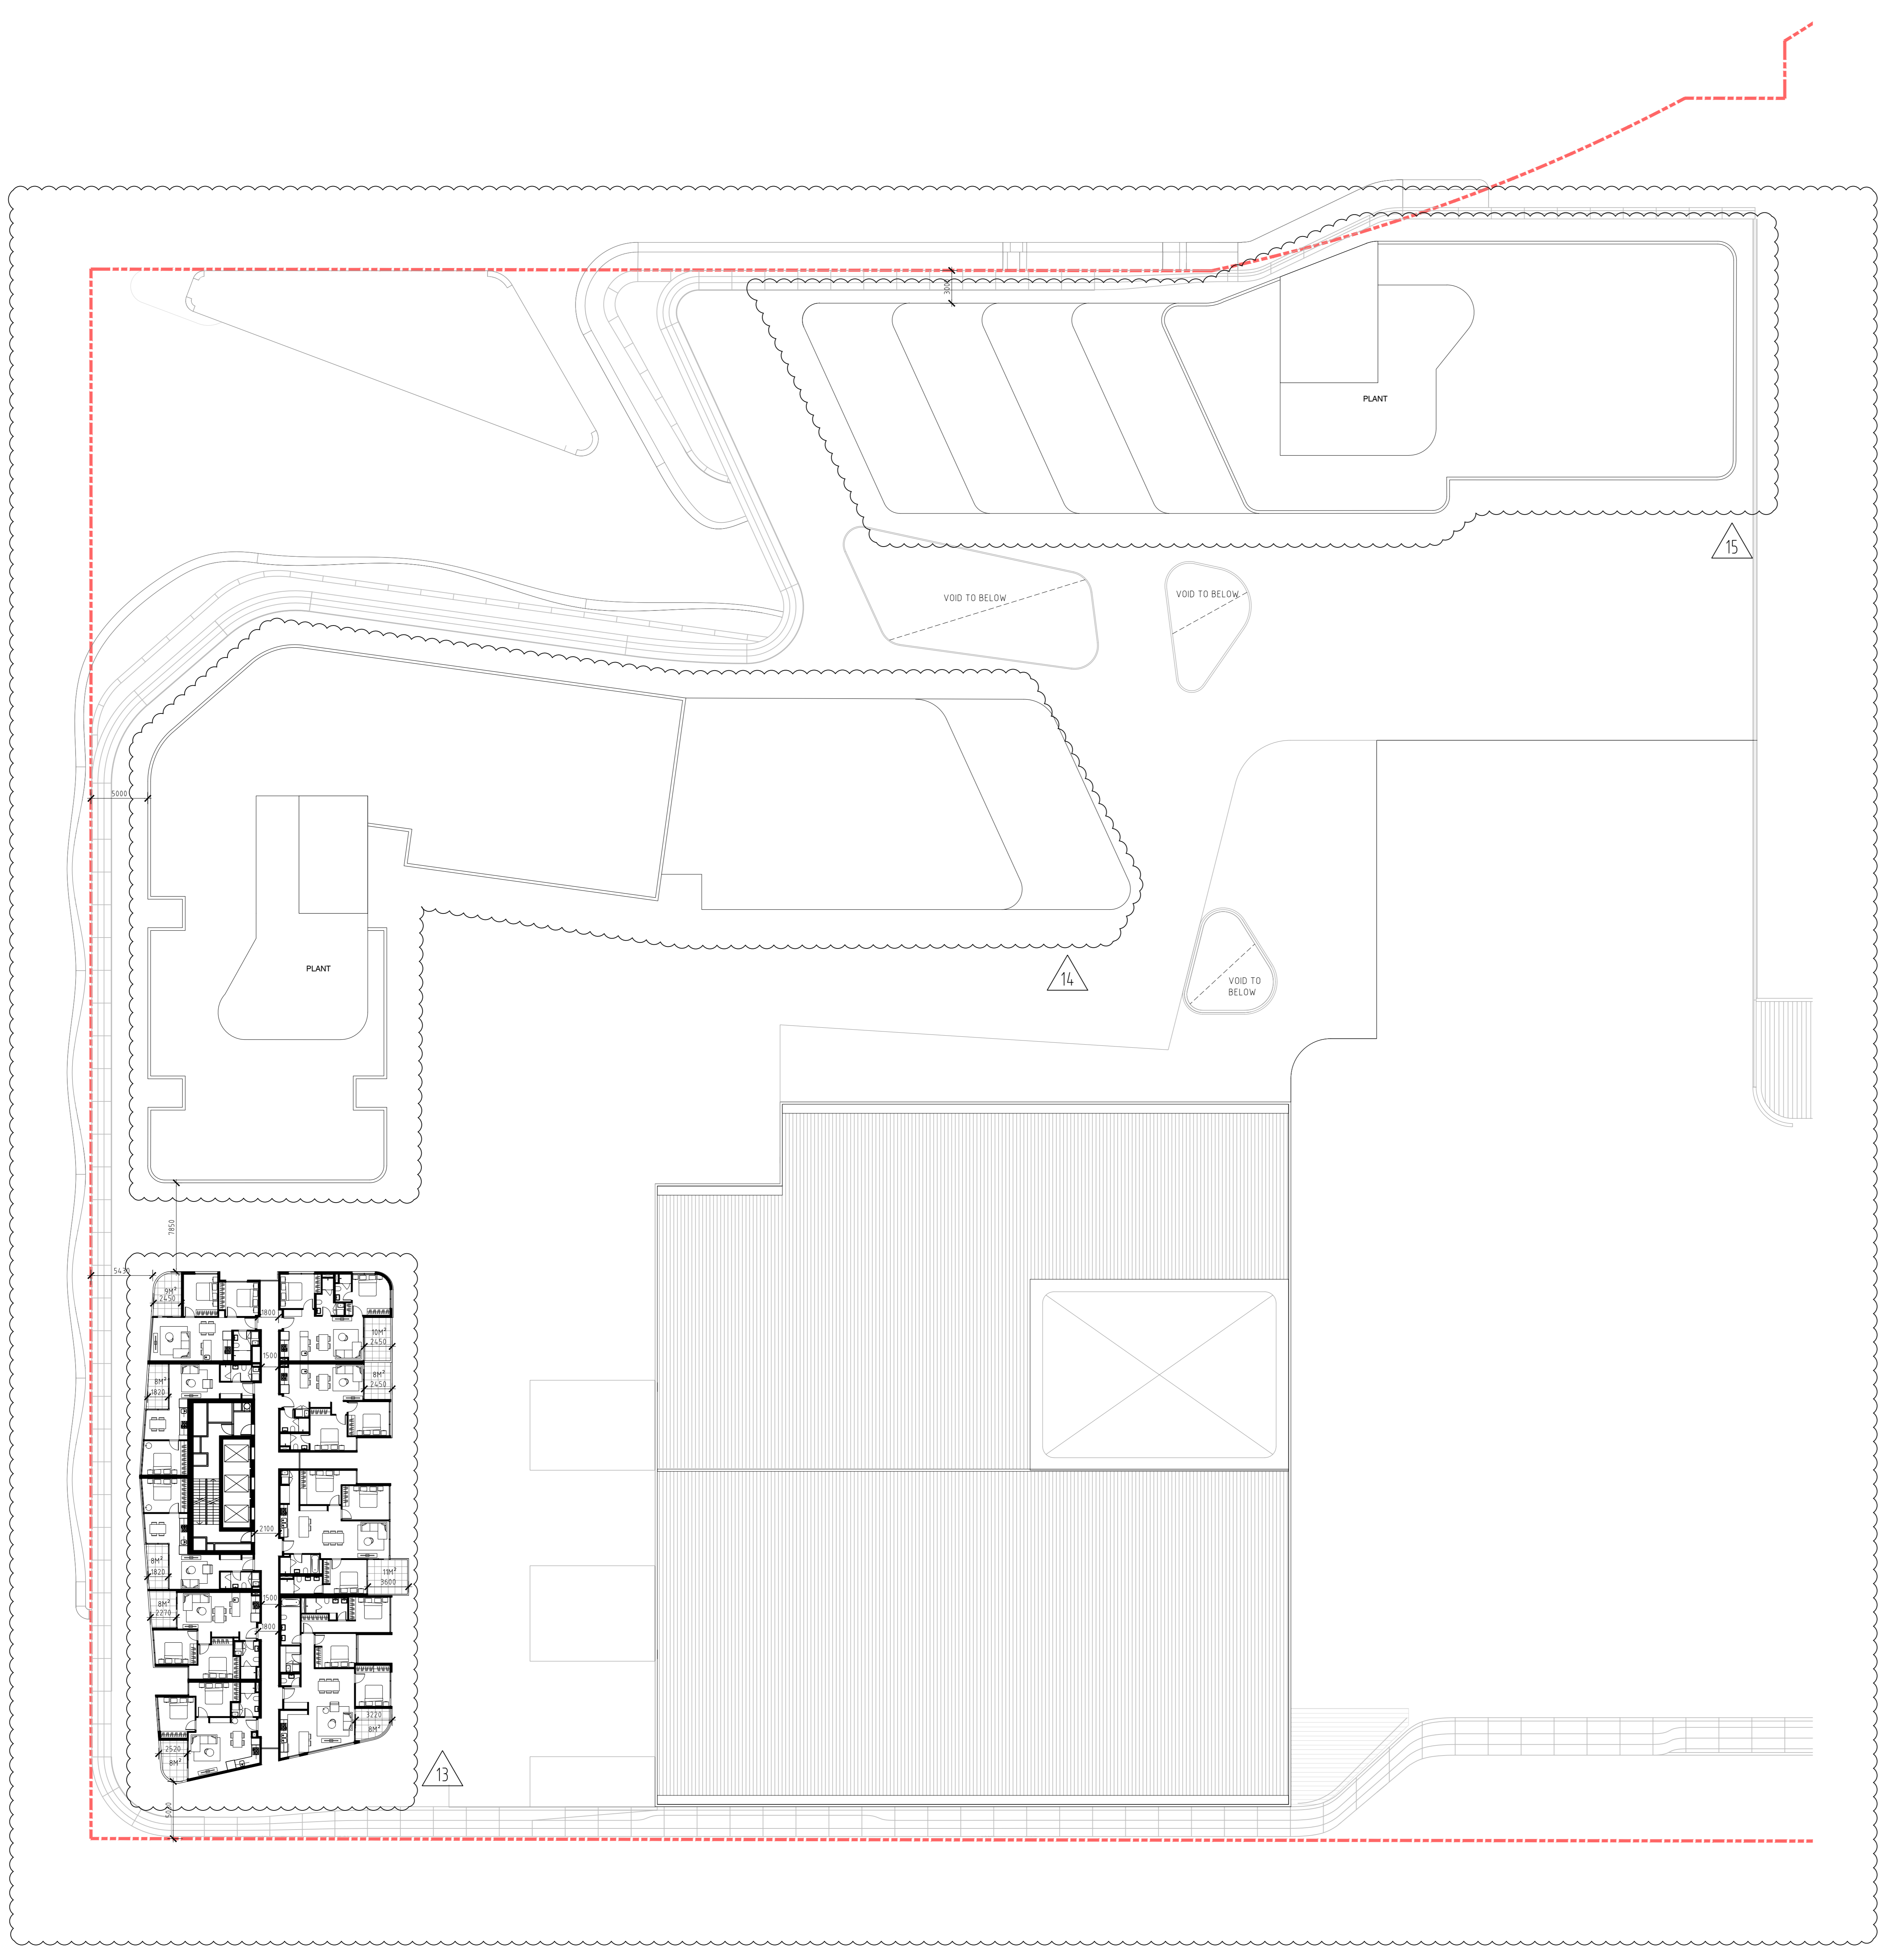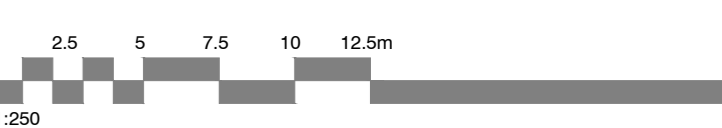


NOTE: EXISTING TREES NOT SHOWN FOR CLARITY

LEGEND

TOWN PLANNING APPLICATION MARCH 2016	TOWN PLANNING ENDORSEMENT JUNE 2016
BASEMENT G2	BASEMENT G2
BASEMENT G1	BASEMENT G1
BASEMENT G0	BASEMENT G0
LEVEL 1	LOWER GROUND
LEVEL 1.5	LOWER GROUND MEZZANINE
LEVEL 2	GROUND LEVEL
LEVEL 3	LEVEL 1
LEVEL 4	LEVEL 2

GENERAL NOTES

ECOLOGICALLY SUSTAINABLE DEVELOPMENT (ESD):  
 THE DEVELOPMENT WILL INCORPORATE A RANGE OF ESD AND WATER SENSITIVE URBAN DESIGN (WSUD) INITIATIVES AND MEET OR EXCEED ALL RELEVANT FEDERAL AND STATE GOVERNMENT STATUTORY OBLIGATIONS WITH REGARD TO ENERGY AND WATER CONSERVATION, PASSIVE DESIGN OF BUILDINGS, WASTE MANAGEMENT, WATER SENSITIVE URBAN DESIGN AND WATER PLANNING PROCESSES. THE PROJECT WILL ALSO BE ASSESSED AGAINST THE GREEN STAR COMMITMENT AND GREEN STAR DESIGN AND IS BUILT SUSTAINABILITY TOOLS AND WILL TARGET A FOUR STAR (BEST PRACTICE) OUTCOME.  
 GREEN STAR COMMITMENT MEETS AND EXCEEDS THE SUSTAINABILITY REQUIREMENTS AS OUTLINED IN THE MOWSHAW PLANNING SCHEME.  
 BALCONY OVERSICING:  
 INTERFERENCE PRIVACY SCREENS MINIMUM 1700MM HEIGHT ALUMINIUM FRAMED GLAZED OPAQUE PANEL.


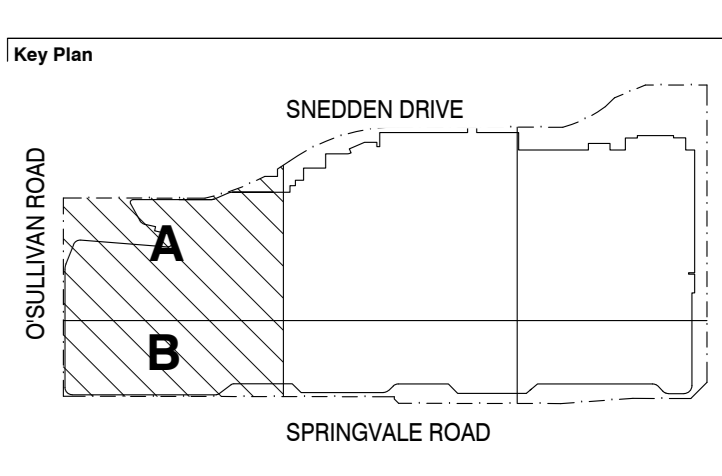


Client  
 Consultant  
 NHArchitecture  
 Level 7 Carrons House  
 12/20 Flinders Lane  
 Melbourne, Australia 3000  
 Telephone: +613 9654 4056  
 Facsimile: +613 9654 4028  
 www.nharchitecture.com.au

LEVEL 19 PLAN  
 TP-46 1:250

Rev.	Date	Description
A	25.06.2018	TS JV ISSUED FOR TOWN PLANNING ENDORSEMENT
B	28.07.2018	TS JV ISSUED FOR TOWN PLANNING AMENDMENT

Do not scale drawings. Use figured dimensions only. All dimensions must be verified on site before commencing work. The standard measurement convention used in architectural drawings is as stated in AS/NZS 1546.1:2011. 

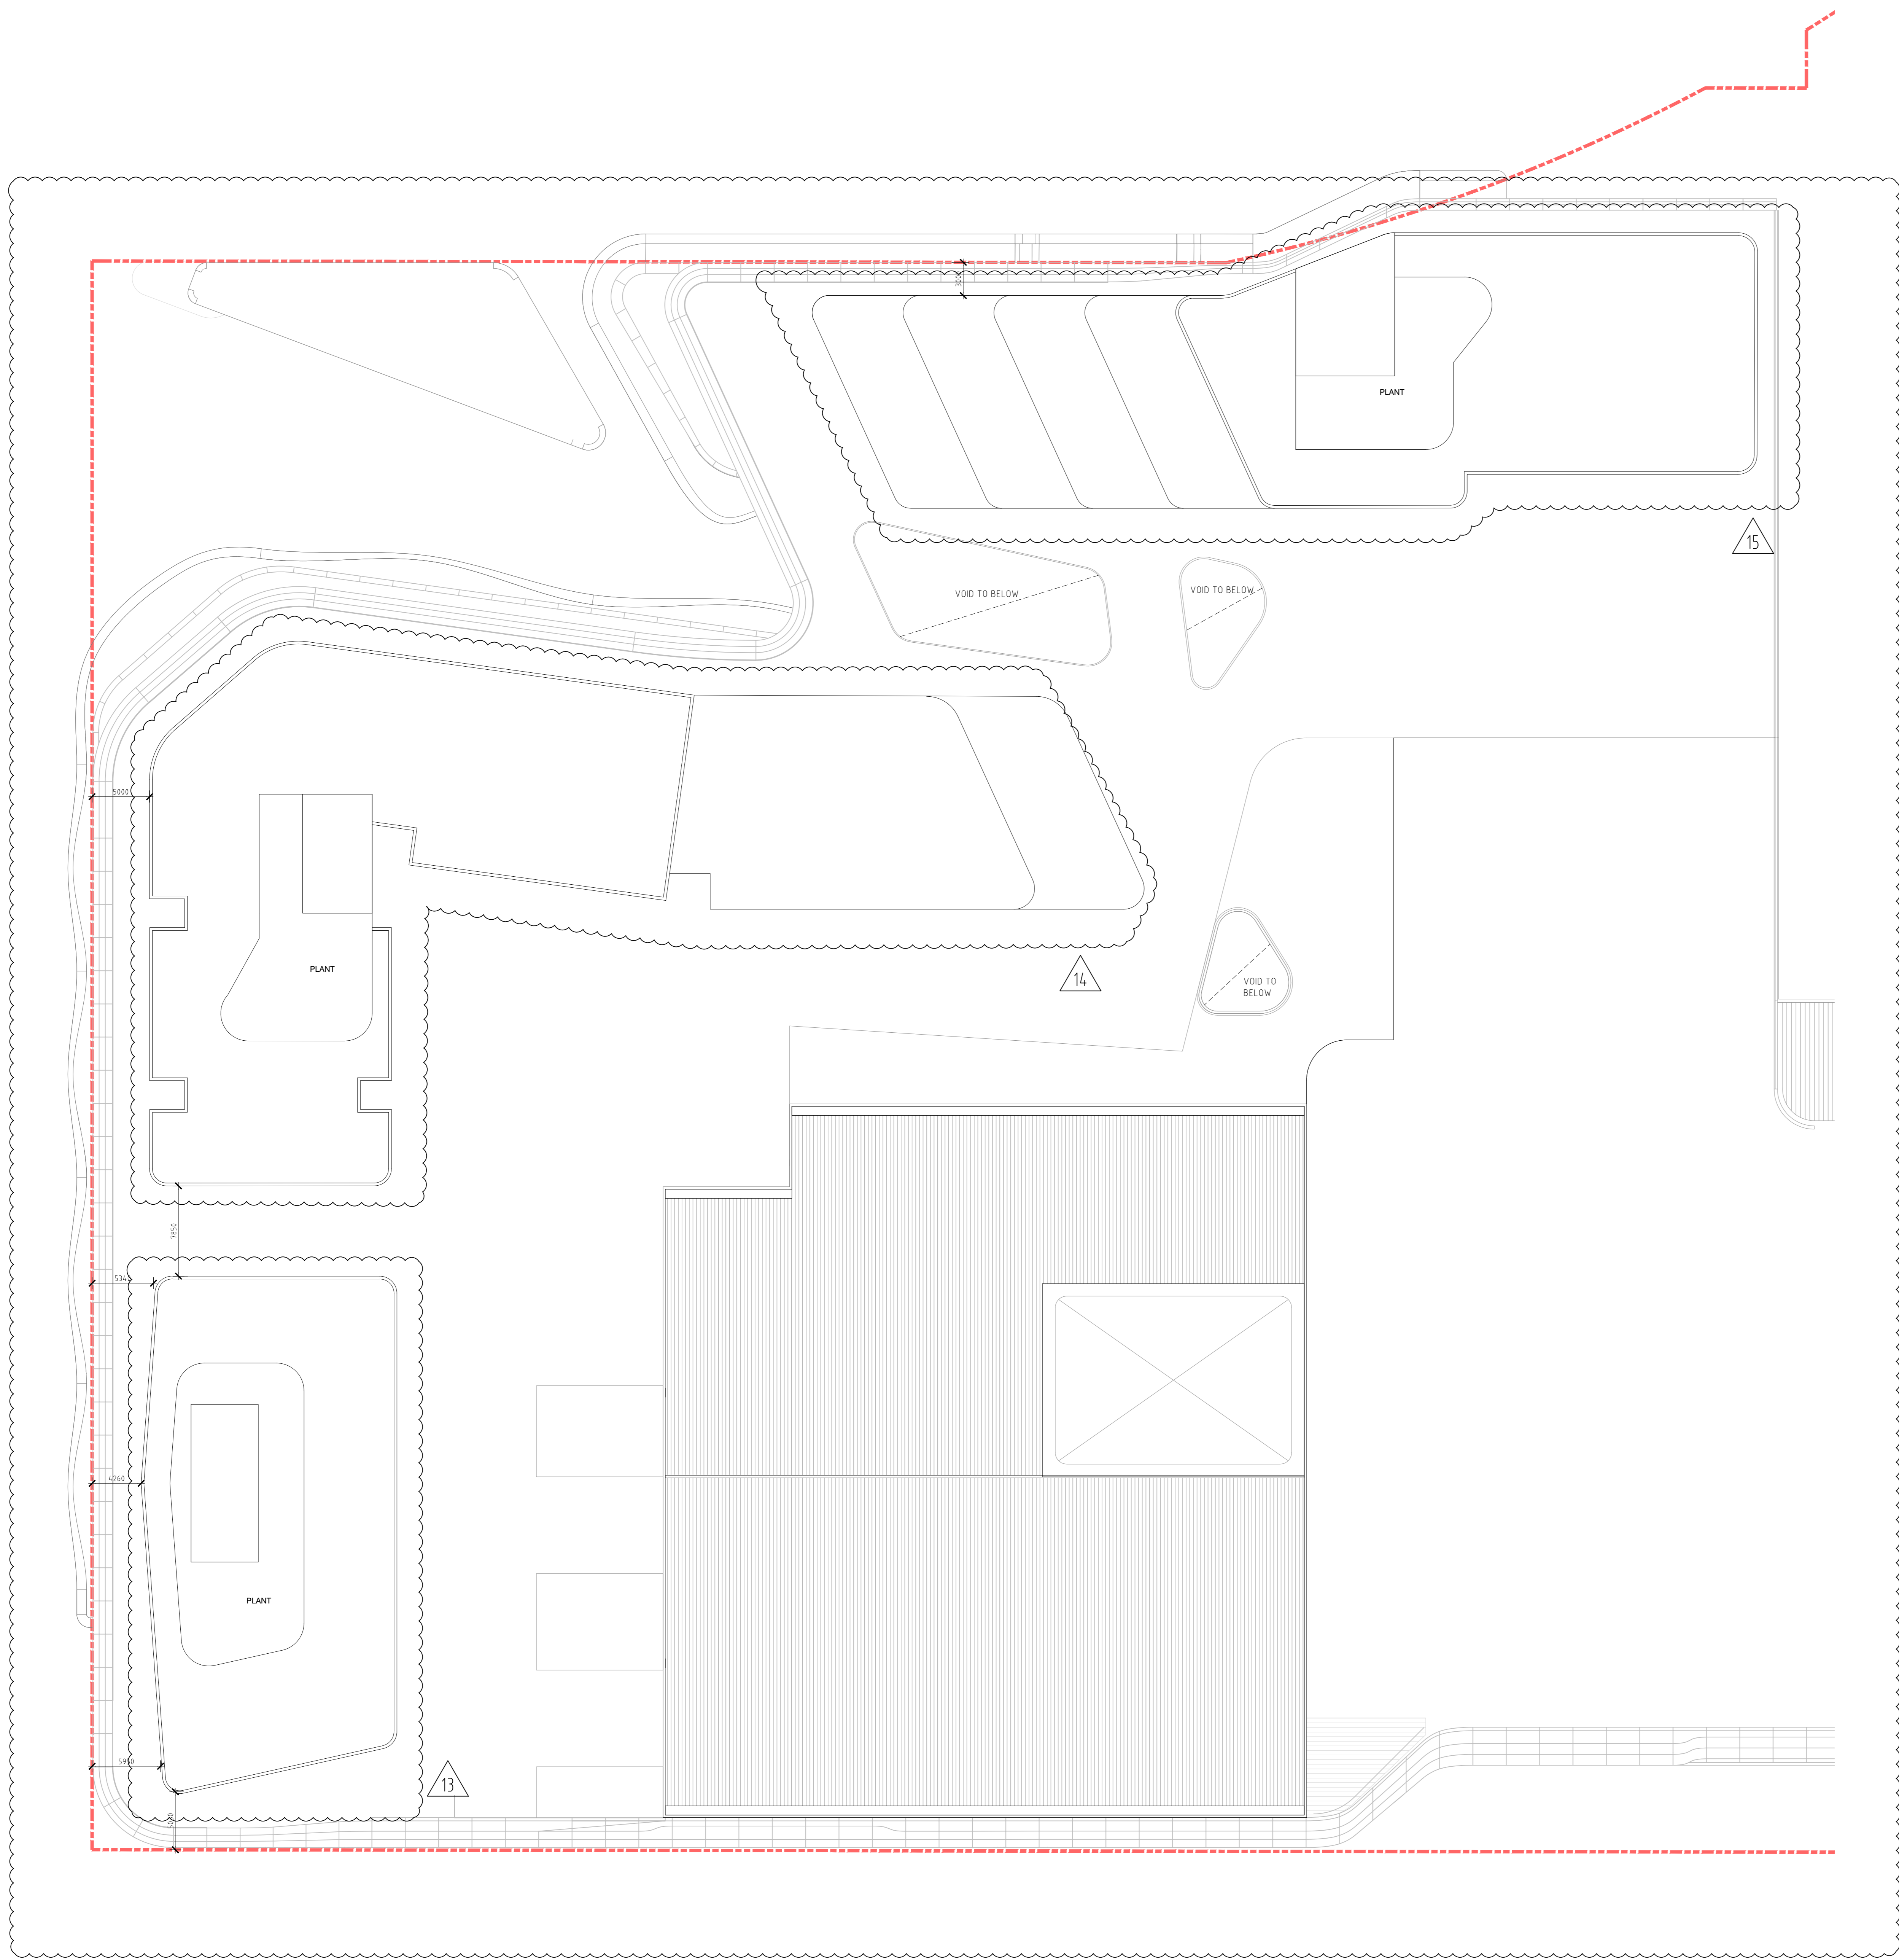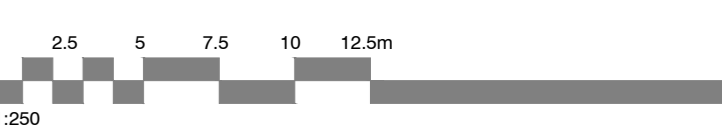


NOTE: EXISTING TREES NOT SHOWN FOR CLARITY

LEGEND	
TOWN PLANNING APPLICATION MARCH 2018	TOWN PLANNING ENDORSEMENT JUNE 2018
LEVEL 1	LOWER GROUND
LEVEL 1.5	LOWER GROUND MEZZANINE
LEVEL 2	GROUND LEVEL
LEVEL 3	LEVEL 1
LEVEL 4	LEVEL 2

**GENERAL NOTES**

ECOLOGICALLY SUSTAINABLE DEVELOPMENT (ESD): THE DEVELOPMENT WILL INCORPORATE A RANGE OF ESD AND WATER SENSITIVE URBAN DESIGN (WSUD) INITIATIVES AND MEET OR EXCEED ALL RELEVANT FEDERAL AND STATE GOVERNMENT STATUTORY OBLIGATIONS WITH REGARD TO ENERGY AND WATER CONSERVATION, PASSIVE DESIGN OF BUILDINGS, WASTE MANAGEMENT, WATER SENSITIVE URBAN DESIGN AND WATER PLANNING PROCESSES. THE PROJECT WILL ALSO BE ASSESSED AGAINST THE GREEN STAR COMMITMENT AND GREEN STAR DESIGN AND IS BUILT SUSTAINABILITY TOOLS AND WILL TARGET A FOUR STAR (BEST PRACTICE) OUTCOME. GREEN STAR COMMITMENT MEETS AND EXCEEDS THE SUSTAINABILITY REQUIREMENTS AS OUTLINED IN THE MOWSHAW PLANNING SCHEME.

BALCONY DIVISIONS: INTERFERENCE PRIVACY SCREENS MINIMUM 1700MM HEIGHT ALUMINIUM FRAMED GLAZED OPAQUE PANEL.

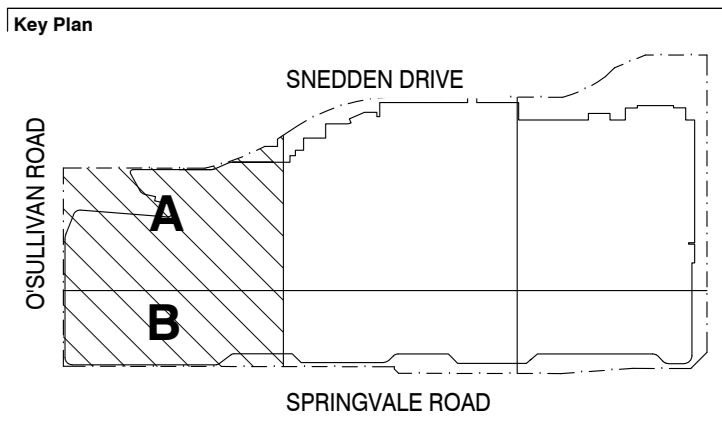

Client: NHArchitecture  
 Level 7 Carrons House  
 12/20 Flinders Lane  
 Melbourne, Australia 3000  
 Telephone: +613 9654 4056  
 Facsimile: +613 9654 4028  
 www.nharchitecture.com.au

Project Name: THE GLEN SHOPPING CENTRE  
 235 Springvale Road, Glen Waverley, 3150

Architect	Drawn By	Scale @ A0
PD	TS	1 : 250
Project Number	Drawing Number	Revision
A120520	TP-49	B

LEVEL 19 PLAN  
 1 : 250